CERTIFICATE OF LOCATION OF GOVERNMENT CORNER

CITY MON. NO. 132

OLD INDEX NO. 1010

1/4 Corner of Section 34 Township 29 Range 23, ____ P.M.

STATE OF MINNESOTA, County of Ramsey

At the corner location shown on the sketch:

On Oct 31, 2009 (date) found a Iron pin, removed and replaced with city of St Paul cim in concrete

☐ left monument as found ☐ lowered monument ☒ removed monument (explain)

On Oct 31, 2009 (date) placed a cim 0.03 below grade

SKETCH OF REFERENCE TIES

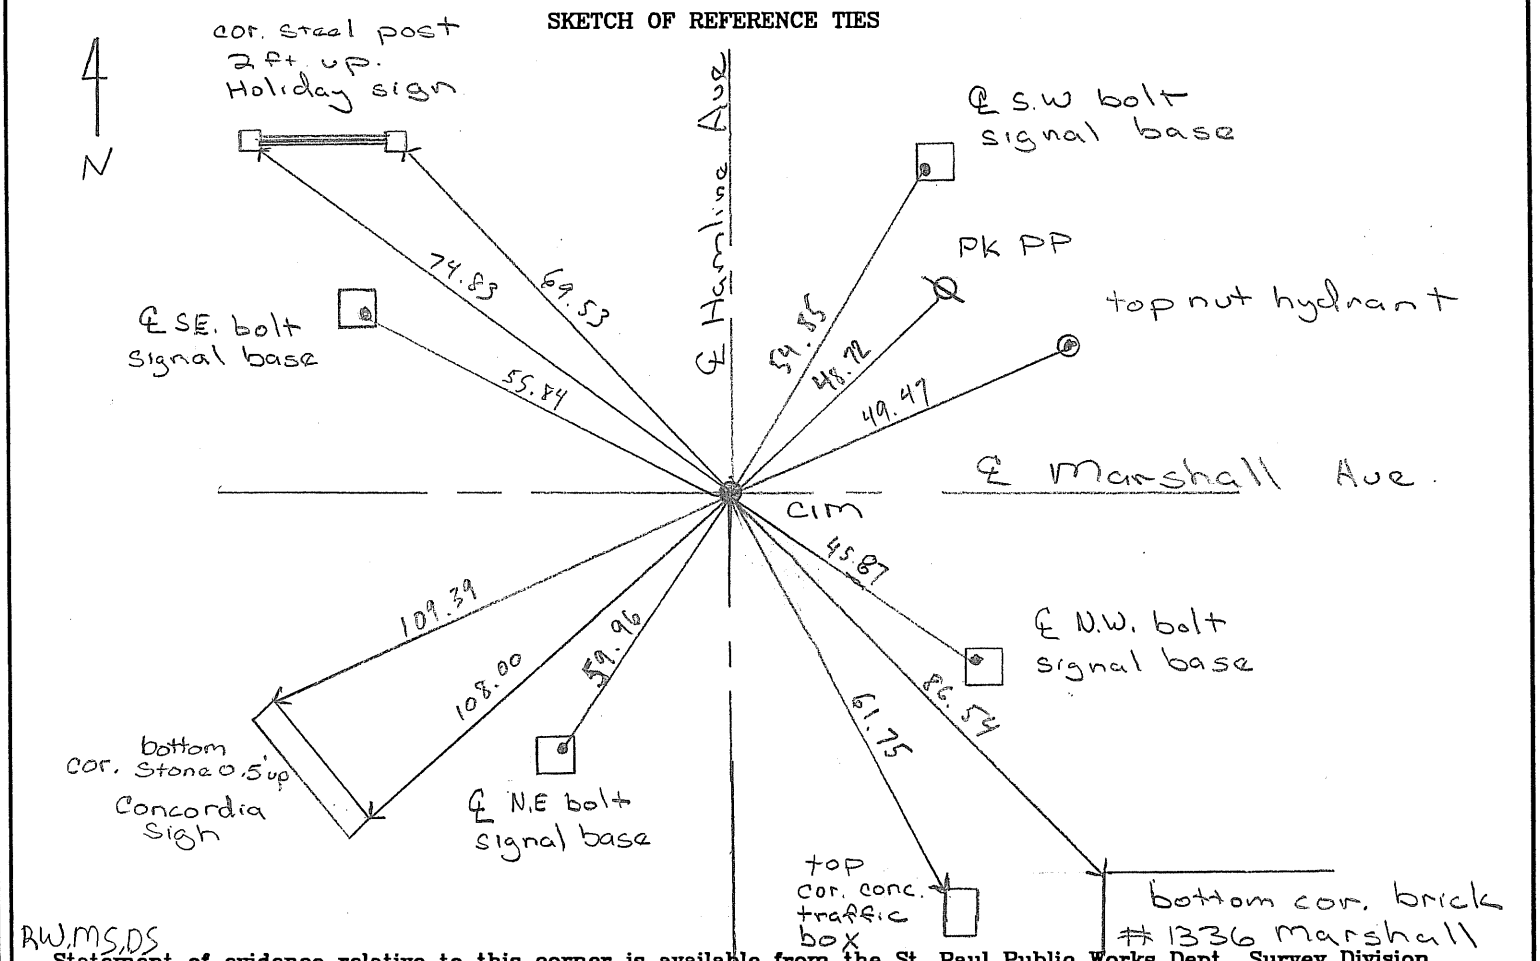

RW, MS, DS

Statement of evidence relative to this corner is available from the St. Paul Public Works Dept., Survey Division

I hereby certify that this document and the data contained herein was prepared by me or under my direct supervision.

NOV 6, 2009

SIGNATURE DATE

Registration No. 44880

☐ Land Surveyor ☐ County Surveyor

☐ Professional Engineer

☑ Chief Surveyor, City of St. Paul

Office of The County Recorder, County of Ramsey

I hereby certify that this document was filed in the county Recorders office at _____.M. on the _____ day of _____

County Recorder _____

By _____, Deputy

DOCUMENT NUMBER _____

SCANNED ON NOV 11 6 2009