

# CERTIFICATE OF LOCATION OF GOVERNMENT CORNER

S. W. Corner of Section 36, Township 29, Range 23, 4th P.M.

STATE OF MINNESOTA, County of \_\_\_\_\_

At the corner location shown on the sketch:


**PICK WOESSNER & CREW**

On Mar 25, 1993 found a Granite Monument .3' Below Bituminous  
DATE \_\_\_\_\_ surface \_\_\_\_\_

left monument as found,  lowered monument,  removed monument (explain)


On \_\_\_\_\_ placed a \_\_\_\_\_  
DATE \_\_\_\_\_

### SKETCH OF REFERENCE TIES

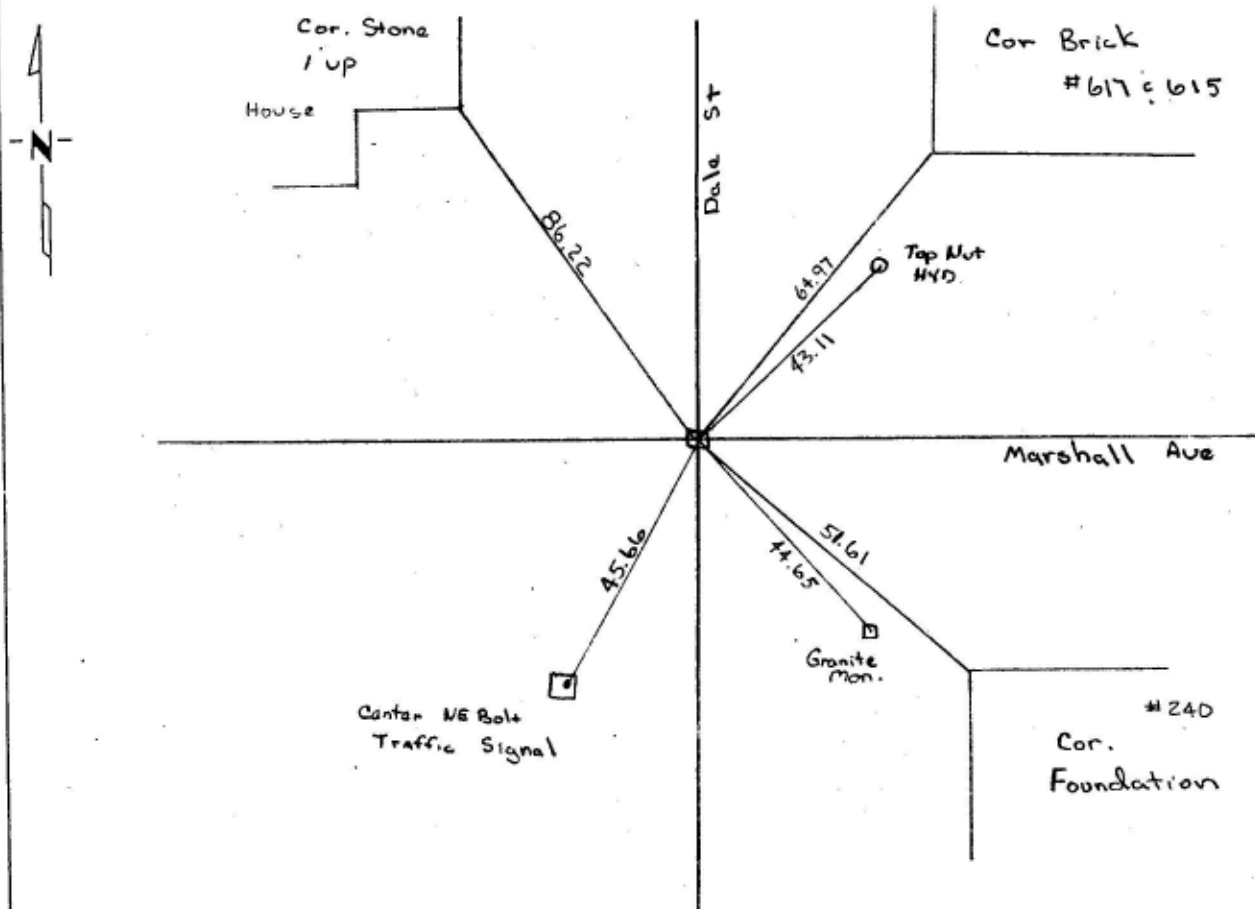

Statement of evidence relative to this corner location is on back of page.

I hereby certify that this document and the data contained herein was prepared by me or under my direct supervision.

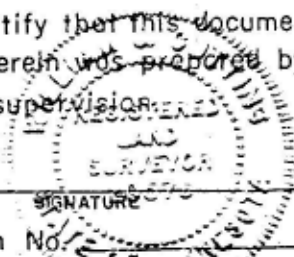

Registration No. \_\_\_\_\_  
 Land Surveyor,  Professional Engineer  
 County Surveyor,  County Engineer

OFFICE OF THE COUNTY RECORDER  
County of \_\_\_\_\_

I hereby certify that this document was filed in the Co. Recorders office at \_\_\_\_\_ .M. on the \_\_\_\_\_ day of \_\_\_\_\_ A.D., 19 \_\_\_\_\_

County Recorder \_\_\_\_\_

By \_\_\_\_\_, Deputy

DOCUMENT NO. \_\_\_\_\_