

CERTIFICATE OF LOCATION OF GOVERNMENT CORNER

South West Corner of Section 31, Township 29, Range 22, 4th P.M.

STATE OF MINNESOTA, County of Ramsey


At the corner location shown on the sketch:

On 9-24-92 found a CIM
DATE

left monument as found, lowered monument, removed monument (explain)

On _____ placed a _____
DATE

SKETCH OF REFERENCE TIES

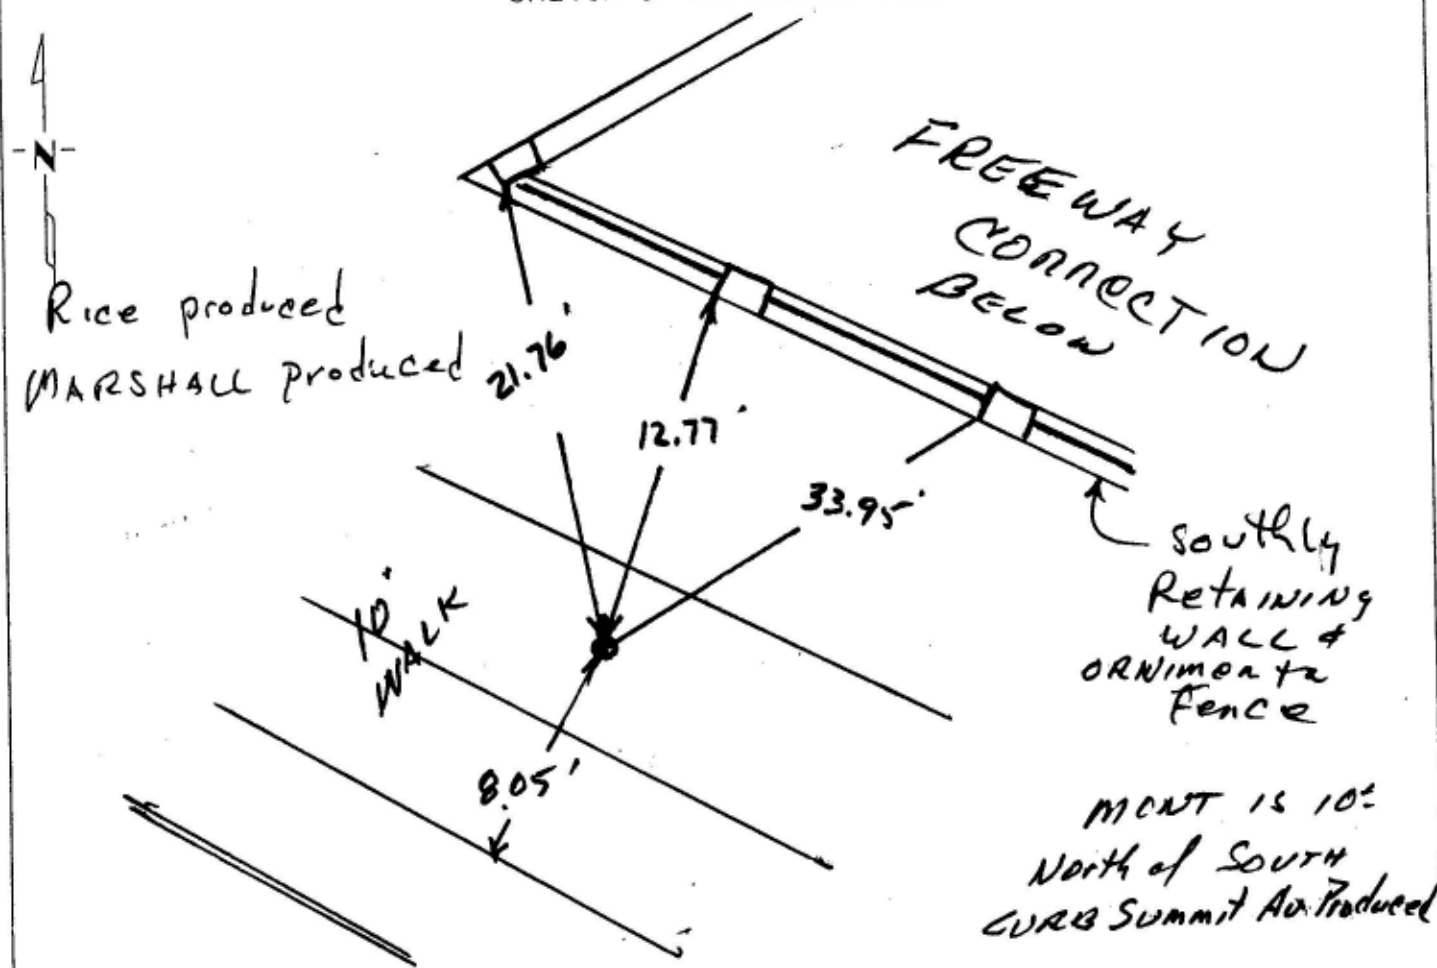

Statement of evidence relative to this corner location is on back of page.

I hereby certify that this document and the data contained herein was prepared by me or under my direct supervision.

William J. Cutler SIGNATURE 9/29/1992 DATE

Registration No. _____
 Land Surveyor, Professional Engineer
 County Surveyor, County Engineer

OFFICE OF THE COUNTY RECORDER
County of _____

I hereby certify that this document was filed in the Co. Recorders office at _____ .M. on the _____ day of _____ A.D., 19 _____

County Recorder _____
By _____, Deputy

DOCUMENT NO. _____

Scanned 5/14/99