

# CERTIFICATE OF LOCATION OF GOVERNMENT CORNER

CITY MON. NO. 157

OLD INDEX NO. 123


CNTR Corner of Section 1 Township 28 Range 23, 4<sup>TH</sup> P.M.

STATE OF MINNESOTA, County of Ramsey  
At the corner location shown on the sketch:

On MAR, 8, 2000 found a C.I.M. at GRADE, RETIED  
date

left monument as found       lowered monument       removed monument (explain)

On \_\_\_\_\_ placed a \_\_\_\_\_  
date

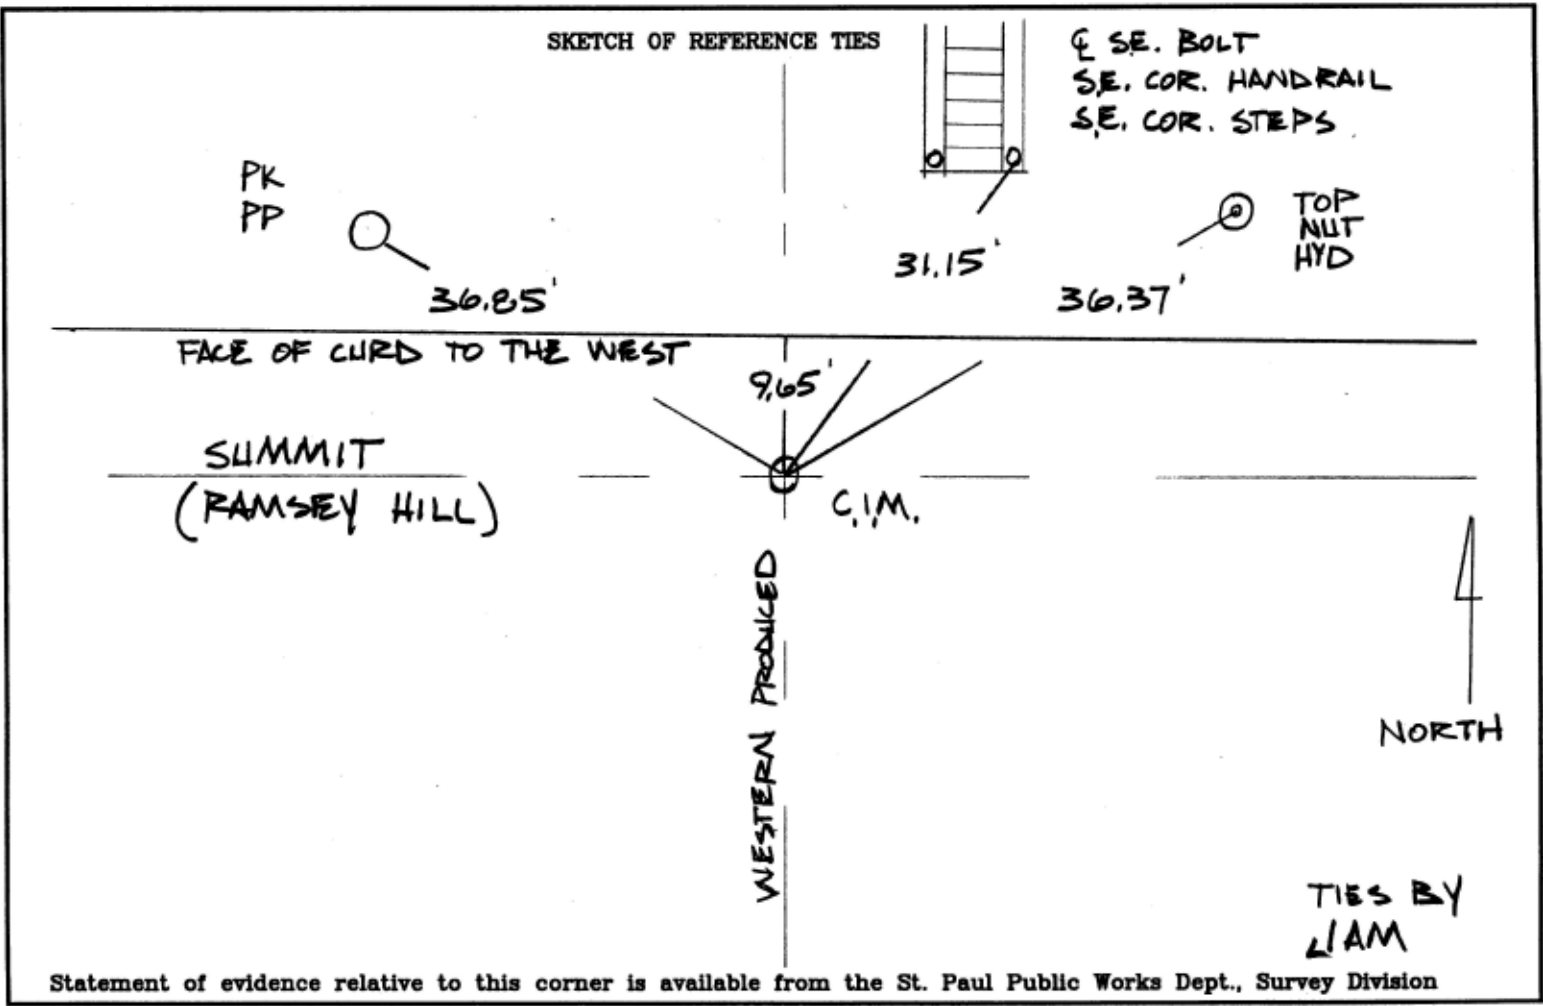

I hereby certify that this document and the data contained herein was prepared by me or under my direct supervision.

*Jeffrey L. Jensen* 4/20/00  
SIGNATURE DATE

Registration No. 13144

Land Surveyor       County Surveyor

Professional Engineer

Chief Surveyor, City of St. Paul

Office of The County Recorder, County of Ramsey

I hereby certify that this document was filed in the county  
Recorders office at \_\_\_\_\_ M. on the \_\_\_\_\_ day of \_\_\_\_\_

County Recorder \_\_\_\_\_

By \_\_\_\_\_, Deputy

DOCUMENT NUMBER \_\_\_\_\_