

CERTIFICATE OF MONUMENT LOCATION

CITY MON. NO. 167

OLD INDEX NO. 2252

Corner in the CENTER Qtr. of Section 2 Township 28 Range 22

STATE OF MINNESOTA, County of Ramsey

At the corner location shown on the sketch:


On March 6, 2001 found a Granite monument 1ft below grade inside

casting with cover

- left monument as found
- lowered monument
- removed monument (explain)

On _____ placed a _____

SKETCH OF REFERENCE TIES

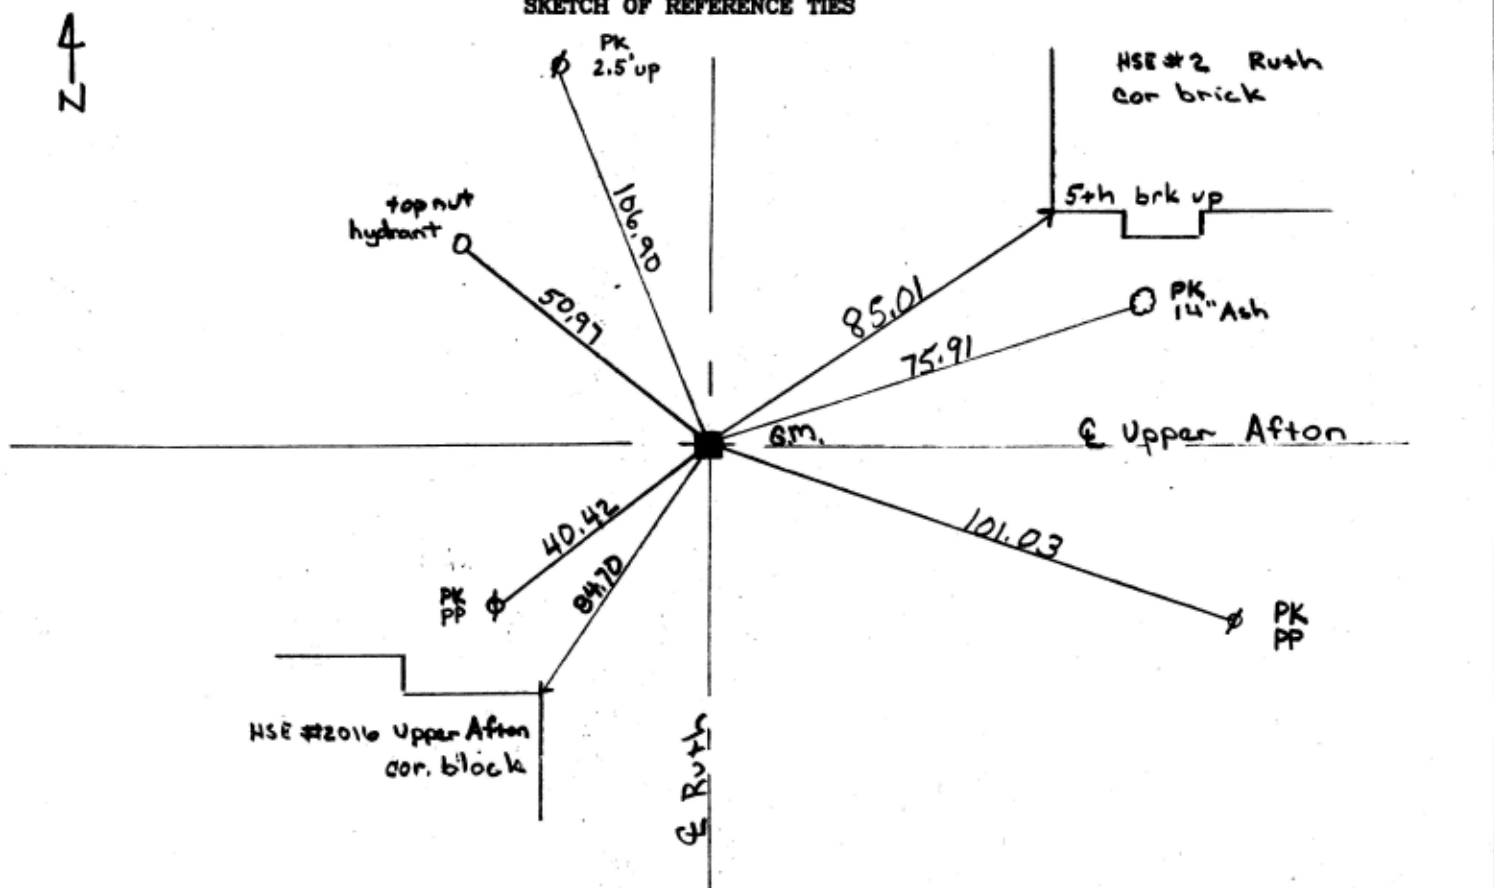

RWMSLL

Statement of evidence relative to this corner is available from the St. Paul Public Works Dept., Survey Division

I hereby certify that this document and the data contained herein was prepared by me or under my direct supervision.

Jeffrey J. Jones 3/8/01
REGISTRAR DATE

Registration No. 13144

- Land Surveyor
- County Surveyor
- Professional Engineer
- Chief Surveyor, City of St. Paul

Office of The County Recorder, County of Ramsey

I hereby certify that this document was filed in the county Recorders office at _____ M. on the _____ day of _____

County Recorder _____

By _____, Deputy

DOCUMENT NUMBER _____