

CERTIFICATE OF MONUMENT LOCATION

CITY MON. NO. 193

OLD INDEX NO. 1294

1/4 Corner in the CENTER Qtr. of Section 9 Township 28 Range 23


STATE OF MINNESOTA, County of Ramsey
At the corner location shown on the sketch:

On OCT. 9, 2010 found a CIM .12 BELOW ASPHALT GRADE
date

- left monument as found lowered monument removed monument (explain)

On OCT. 9, 2010 placed NEW TIES
date

SKETCH OF REFERENCE TIES

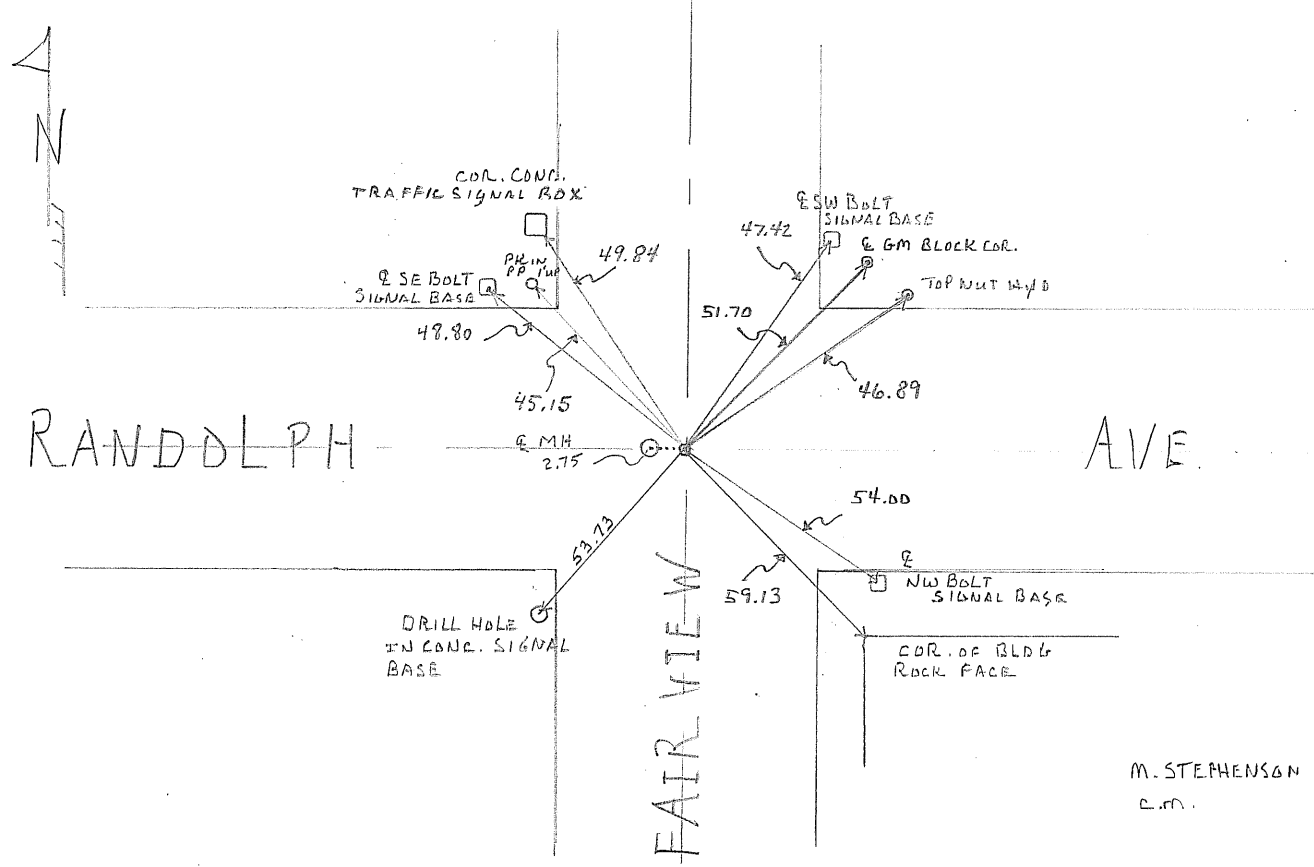

Statement of evidence relative to this corner is available from the St. Paul Public Works Dept., Survey Division

I hereby certify that this document and the data contained herein was prepared by me or under my direct supervision.

[Signature] OCT 13, 2010
SIGNATURE DATE

- Registration No. 44880
- Land Surveyor County Surveyor
- Professional Engineer
- Chief Surveyor, City of St. Paul

Office of The County Recorder, County of Ramsey

I hereby certify that this document was filed in the county
Recorders office at _____ M. on the _____ day of _____

County Recorder _____

By _____, Deputy

DOCUMENT NUMBER _____