

CERTIFICATE OF LOCATION OF GOVERNMENT CORNER


Center Corner of Section 11, Township 28, Range 23, _____ P.M.

STATE OF MINNESOTA, County of RANSEY

At the corner location shown on the sketch:

- On _____ found a _____
DATE
- left monument as found, lowered monument, removed monument (explain)
- On 7 NOV 94 placed a CAST IRON MONUMENT IN CONCRETE
DATE

SKETCH OF REFERENCE TIES

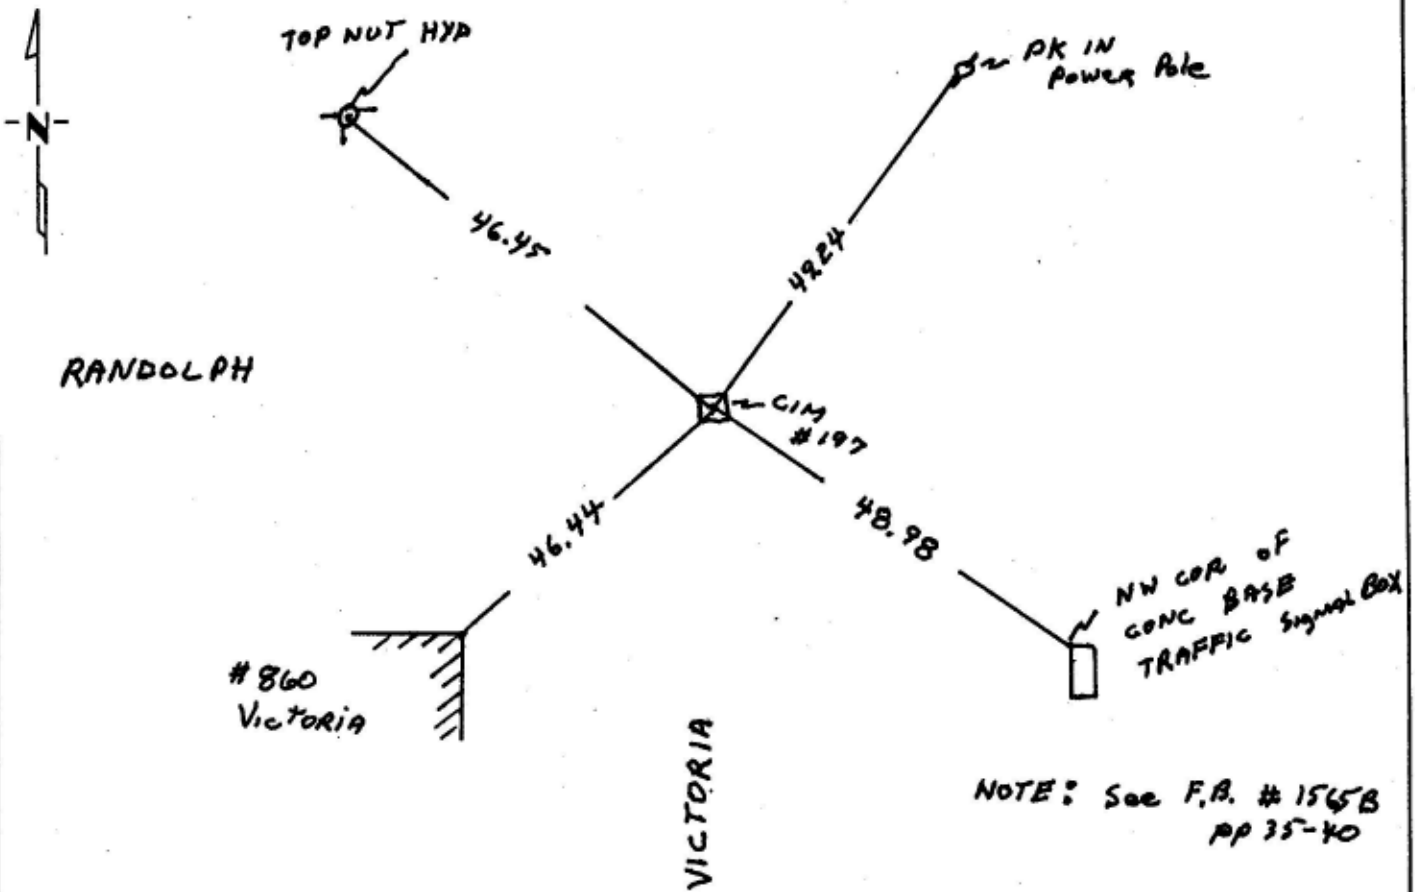

NOTE: See F.B. # 1565B pp 35-40

Statement of evidence relative to this corner location is on back of page.

I hereby certify that this document and the data contained herein was prepared by me or under my direct supervision.

William J. Sutherland 11/21/97
SIGNATURE DATE

- Registration No. _____
- Land Surveyor, Professional Engineer
 - County Surveyor, County Engineer

OFFICE OF THE COUNTY RECORDER
County of _____

I hereby certify that this document was filed in the Co. Recorders office at _____ .M. on the _____ day of _____ A.D., 19 _____

County Recorder _____
By _____, Deputy
DOCUMENT NO. _____