

CERTIFICATE OF LOCATION OF GOVERNMENT CORNER

City ID: 0198
Old Index #: 0155


E 1/4 Corner of Section 11 Township 28 Range 23, 4th P.M.
STATE OF MINNESOTA, County of Ramsey
At the corner location shown on the sketch:

On Sept 27, 2012 found a CIM at street grade.

left monument as found lowered monument removed monument (explain)

On _____ placed a _____

SKETCH OF REFERENCE TIES

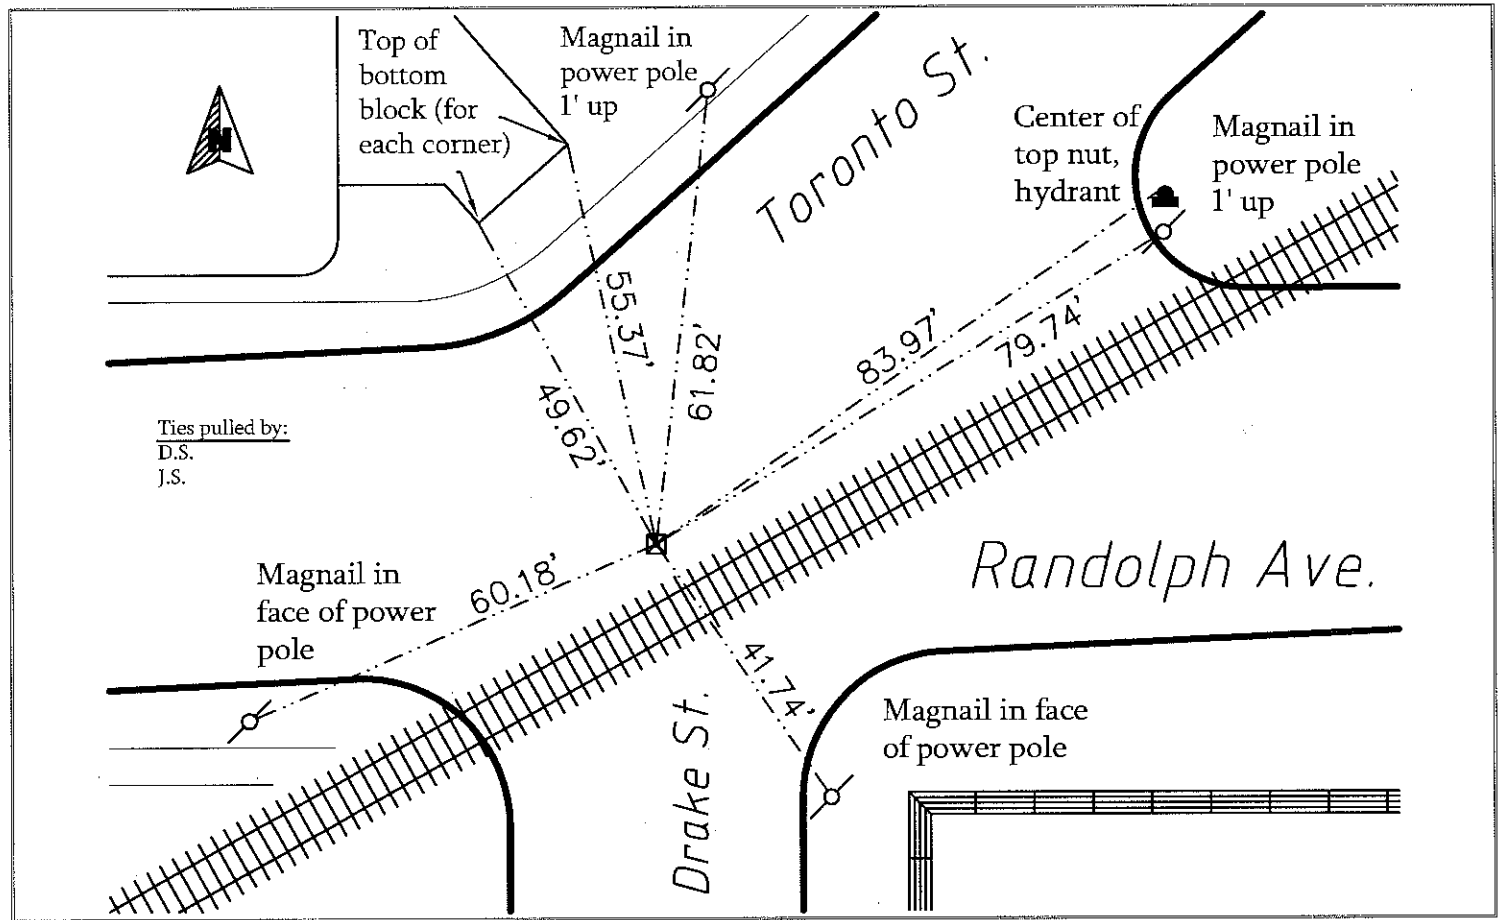

Statement of evidence relative to this corner is available from the St. Paul Public Works Dept., Survey Division

I hereby certify that this document and the data contained herein was prepared by me or under my direct supervision.

[Signature] JAN 2, 2013
Registration No. 44880

- Land Surveyor County Surveyor
- Professional Engineer
- Chief Surveyor, City of St. Paul

Office of the County Recorder, County of Ramsey
I hereby certify that this document was filed in the county recorders office at _____ M. on the _____ day of _____

County Recorder _____

By _____, Deputy

DOCUMENT NUMBER _____