


CERTIFICATE OF LOCATION OF GOVERNMENT CORNER

CENTER Corner of Section 7, Township 28, Range 22, 4TH P.M.

STATE OF MINNESOTA, County of Ramsey

At the corner location shown on the sketch:

- On JUNE 2, 2005 found a CIM @ GRADE
DATE
- left monument as found, lowered monument, removed monument (explain)
DUE TO CONSTRUCTION
- On JULY 12, 2006 placed a CIM @ GRADE MARKED "CENTER SECTION"
DATE

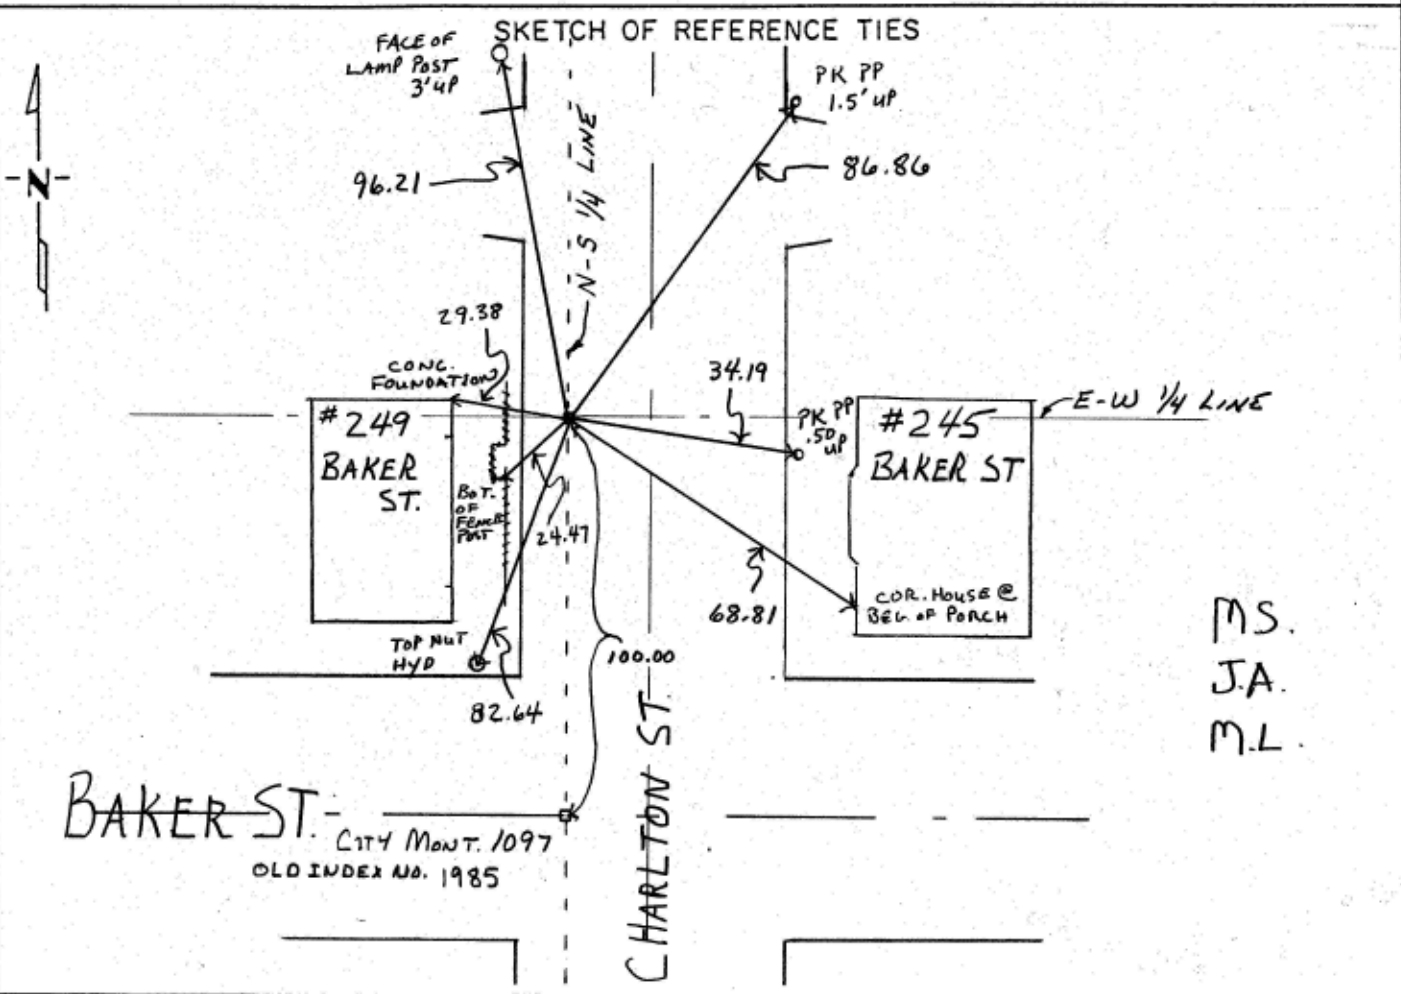

Statement of evidence relative to this corner location is on back of page.

I hereby certify that this document and the data contained herein was prepared by me or under my direct supervision.

Michael P. Murphy SIGNATURE 7/19/06 DATE

Registration No. 41,000

Land Surveyor, Professional Engineer

County Surveyor, County Engineer

OFFICE OF THE COUNTY RECORDER

County of _____

I hereby certify that this document was filed in the Co. Recorders office at _____ .M. on the _____ day of _____ A.D., 19 _____

County Recorder _____

By _____, Deputy

DOCUMENT NO. _____