

# CERTIFICATE OF LOCATION OF GOVERNMENT CORNER

CITY MON. NO. 0221

OLD INDEX NO. 0175


SECTION          Corner of Section 12 & 13 Township 28 Range 23, 4<sup>th</sup> P.M.

STATE OF MINNESOTA, County of Ramsey  
At the corner location shown on the sketch:

On Nov. 26, 2012 found a DISC w/ PK IN CENTER @ MOUNT. POSITION  
date

left ~~monument~~ <sup>disc</sup> as found       lowered monument       removed monument (explain)

On \_\_\_\_\_ placed a \_\_\_\_\_  
date

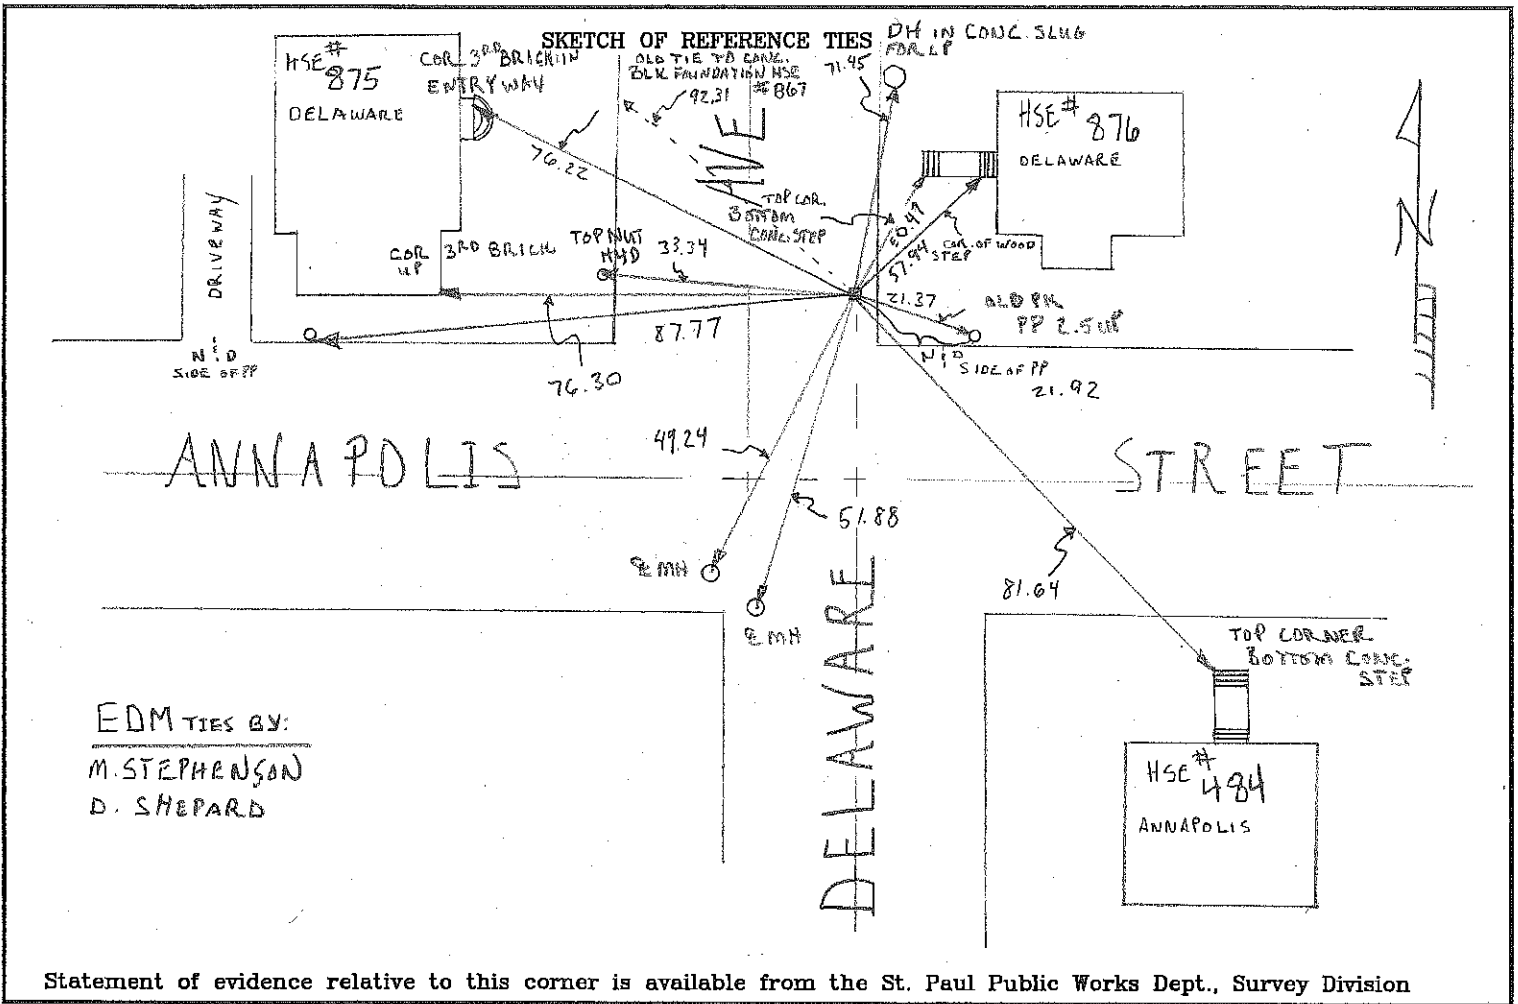

Statement of evidence relative to this corner is available from the St. Paul Public Works Dept., Survey Division

I hereby certify that this document and the data contained herein was prepared by me or under my direct supervision.

[Signature]      Dec 24, 2012  
SIGNATURE      DATE

Registration No. 44880  
 Land Surveyor       County Surveyor  
 Professional Engineer  
 Chief Surveyor, City of St. Paul

Office of The County Recorder, County of Ramsey

I hereby certify that this document was filed in the county  
Recorders office at \_\_\_\_\_ M. on the \_\_\_\_\_ day of \_\_\_\_\_

County Recorder \_\_\_\_\_  
By \_\_\_\_\_, Deputy

DOCUMENT NUMBER \_\_\_\_\_