

CERTIFICATE OF LOCATION OF GOVERNMENT CORNER

CITY MON. NO. 0224
OLD INDEX NO. — fd

S 1/4 Corner of Section 8 Township 28 Range 22, 4th P.M.


STATE OF MINNESOTA, County of Ramsey
At the corner location shown on the sketch:

On Nov. 26, 2012 found a PIN BROKEN OFF BELOW ASPHALT

GRADE MONUMENT LOCATION

- left ^{PIN} monument as found
- lowered monument
- removed monument (explain)

On Nov. 26, 2012 placed TIES - PHOTOS - GPS

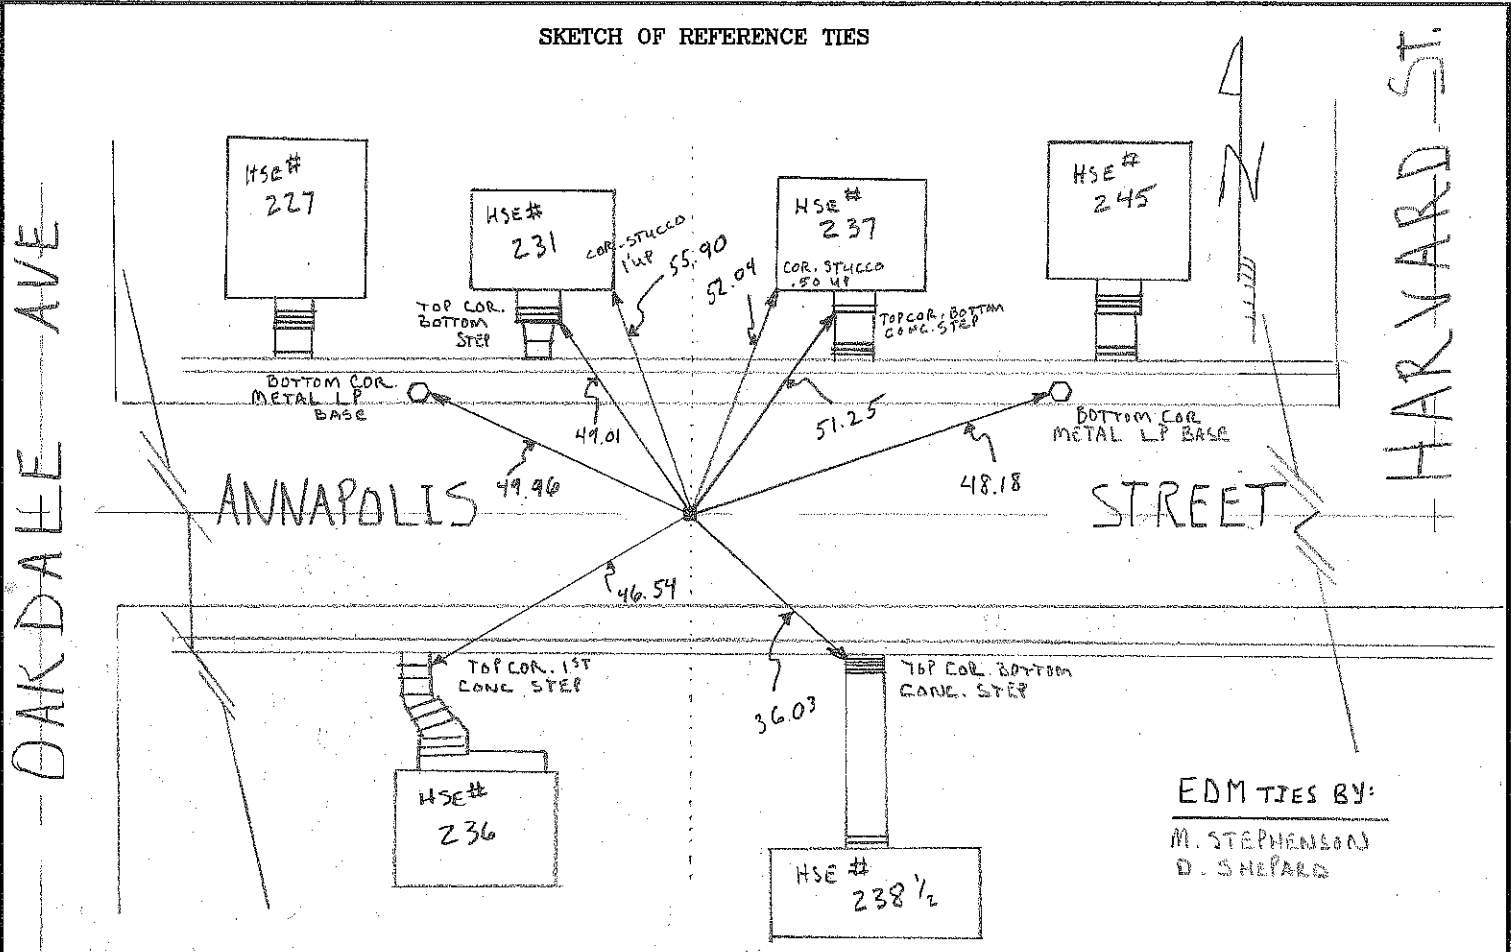

EDM TIES BY:
M. STEPHENSON
D. SHEPARD

Statement of evidence relative to this corner is available from the St. Paul Public Works Dept., Survey Division

I hereby certify that this document and the data contained herein was prepared by me or under my direct supervision.

[Signature] Dec 24, 2012
SIGNATURE DATE

- Registration No. 44880
- Land Surveyor
 - County Surveyor
 - Professional Engineer
 - Chief Surveyor, City of St. Paul

Office of The County Recorder, County of Ramsey

I hereby certify that this document was filed in the county Recorders office at _____ M. on the _____ day of _____

County Recorder _____

By _____, Deputy

DOCUMENT NUMBER _____