

CERTIFICATE OF LOCATION OF GOVERNMENT CORNER

1/4 Corner of Section 16, Township 28, Range 23, _____ P.M.


STATE OF MINNESOTA, County of RAMSEY

At the corner location shown on the sketch:

- On _____ found a _____
DATE
- left monument as found, lowered monument, removed monument (explain)

On 9/26/95 placed 2.0' STRADDLES ACCORDING TO TIES,
DATE MONT REMOVED FOR CONSTRUCTION this done by Marshall crew

SKETCH OF REFERENCE TIES

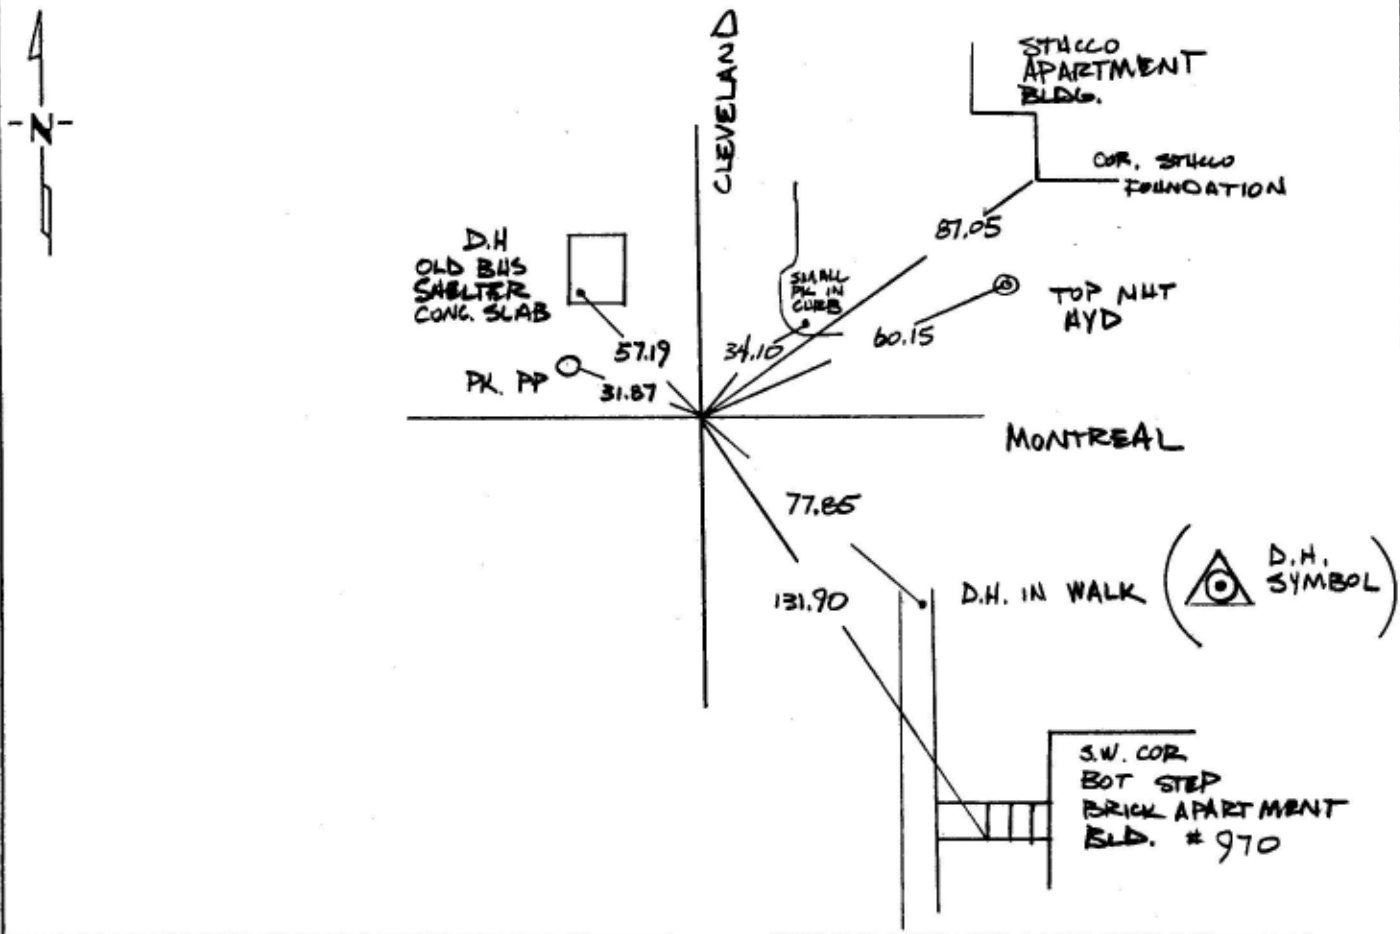

Statement of evidence relative to this corner location is on back of page.

I hereby certify that this document and the data contained herein was prepared by me or under my direct supervision.

SIGNATURE DATE

- Registration No. _____
- Land Surveyor, Professional Engineer
 - County Surveyor, County Engineer

OFFICE OF THE COUNTY RECORDER
County of _____

I hereby certify that this document was filed in the Co. Recorders office at _____ M. on the _____ day of _____ A.D., 19 _____

County Recorder _____

By _____, Deputy

DOCUMENT NO. _____