

CERTIFICATE OF LOCATION OF GOVERNMENT CORNER

1/4 Corner of Section 15, Township 28, Range 23, 4th P.M.


STATE OF MINNESOTA, County of RAMSEY

At the corner location shown on the sketch:

On 9/26/95 found a MH COVER OCCUPYING LOCATION OF MONT
PLACED 2.0' STRADDLES ACCORDING TO TIES
 left monument as found, lowered monument, removed monument (explain)

On _____ placed a _____
DATE

SKETCH OF REFERENCE TIES

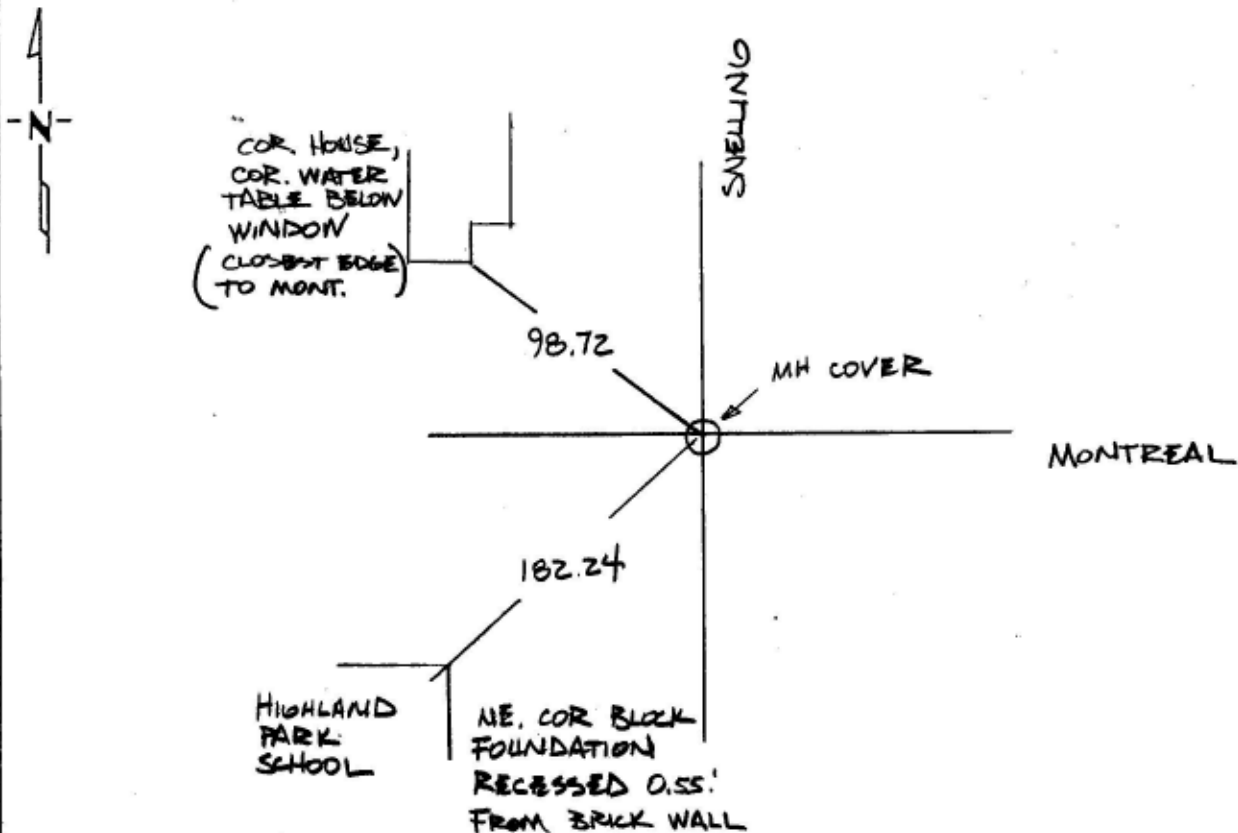

Statement of evidence relative to this corner location is on back of page.

I hereby certify that this document and the data contained herein was prepared by me or under my direct supervision

William J. Gillingham 10/20/95
SIGNATURE DATE

Registration No. 20573

- Land Surveyor Professional Engineer
- County Surveyor County Engineer

OFFICE OF THE COUNTY RECORDER

County of _____

I hereby certify that this document was filed in the Co. Recorders office at _____ .M. on the _____ day of _____ A.D., 19 _____

County Recorder _____

By _____, Deputy

DOCUMENT NO. _____