

CERTIFICATE OF MONUMENT LOCATION

CITY MON. NO. 239

OLD INDEX NO. 2696

SECTION Corner in the NW Qtr. of Section 14 Township 28 Range 23

STATE OF MINNESOTA, County of Ramsey

At the corner location shown on the sketch:


On FEB. 12, 2007 found a GM .30 ABOVE GRADE (MONTREAL AVE.

^{date}
PRODUCED & VICTORIA ST. PRODUCED)

left monument as found lowered monument removed monument (explain)

On FEB 13, 2007 placed & BASE LINE GPS TIES AND TOOK PICTURES
^{date}

SKETCH OF REFERENCE TIES

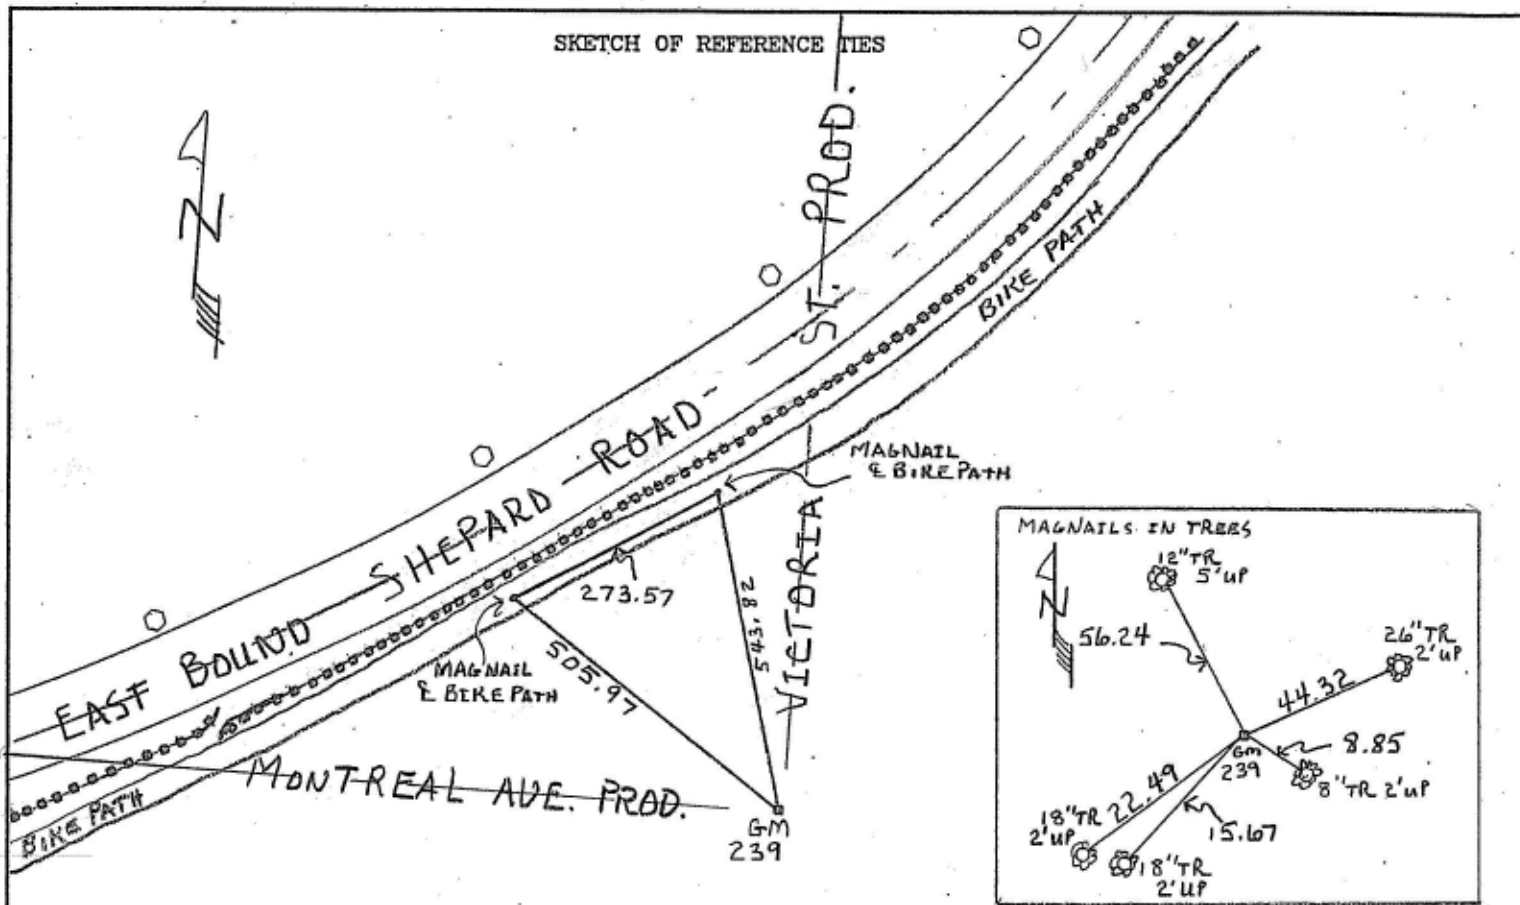

M.S. - J.A. - C.M.

Statement of evidence relative to this corner is available from the St. Paul Public Works Dept., Survey Division

I hereby certify that this document and the data contained herein was prepared by me or under my direct supervision.

Office of The County Recorder, County of Ramsey

I hereby certify that this document was filed in the county Recorders office at _____ M. on the _____ day of _____

SIGNATURE

DATE

Registration No. _____

- Land Surveyor County Surveyor
- Professional Engineer
- Chief Surveyor, City of St. Paul

County Recorder: _____

By _____, Deputy

DOCUMENT NUMBER _____