

CERTIFICATE OF LOCATION OF GOVERNMENT CORNER

SECTION Corner of Section 21, Township 28, Range 23, 4th P.M.


STATE OF MINNESOTA, County of RAMSEY

At the corner location shown on the sketch:

- On 9/25/95 found a CAST IRON MONT. ENCASED IN METAL CYLINDER
DATE
- left monument as found, lowered monument, removed monument (explain)
- On _____ placed a _____
DATE

SKETCH OF REFERENCE TIES

J.M. & Crew

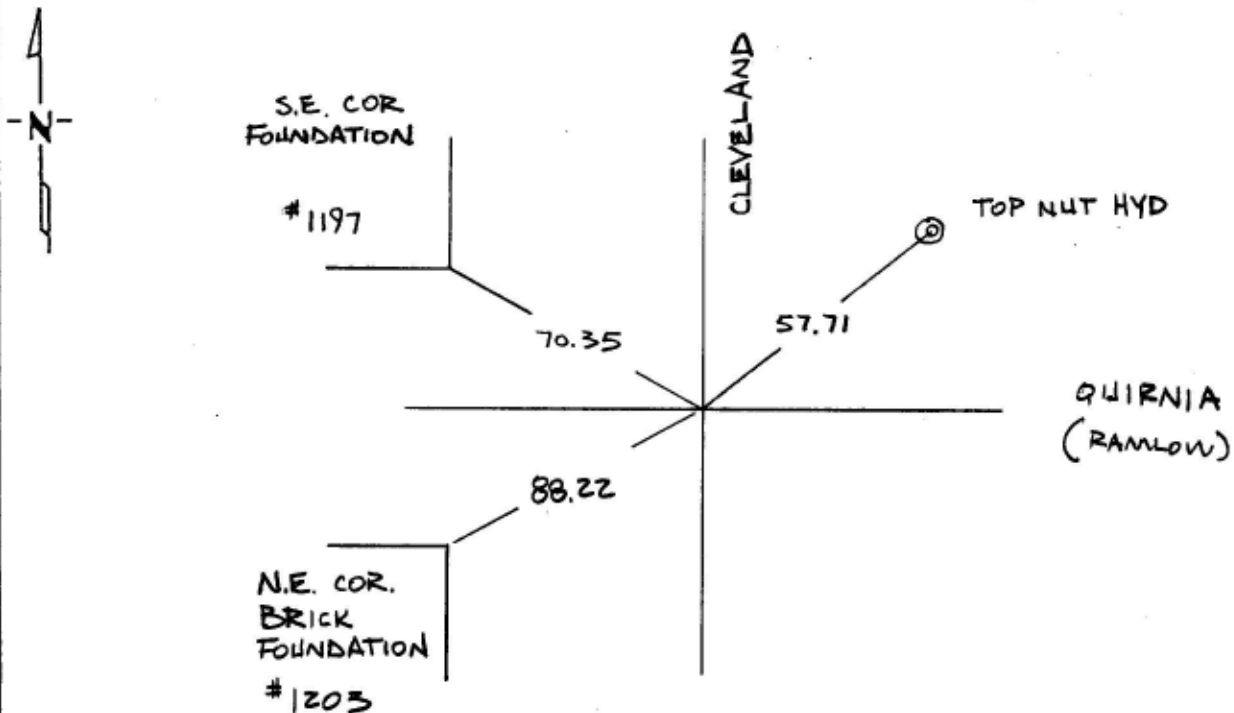

Statement of evidence relative to this corner location is on back of page.

I hereby certify that this document and the data contained herein was prepared by me or under my direct supervision.

William J. ...
SIGNATURE DATE 10/20/95

Registration No. _____

- Land Surveyor, Professional Engineer
- County Surveyor, County Engineer

OFFICE OF THE COUNTY RECORDER

County of _____

I hereby certify that this document was filed in the Co. Recorders office at _____ .M. on the _____ day of _____ A.D., 19 _____

County Recorder _____

By _____, Deputy

DOCUMENT NO. _____