

CERTIFICATE OF LOCATION OF GOVERNMENT CORNER

1/4 Corner of Section 21, Township 28, Range 23, P.M.

STATE OF MINNESOTA, County of Ramsey

At the corner location shown on the sketch:

On 1-11-93 found a Granite Monument

left mon. as found lowered mon. removed mon.(explain)


On _____ placed a _____

SKETCH OF REFERENCE TIES

#256


18° F

Distances uncorrected for temp.

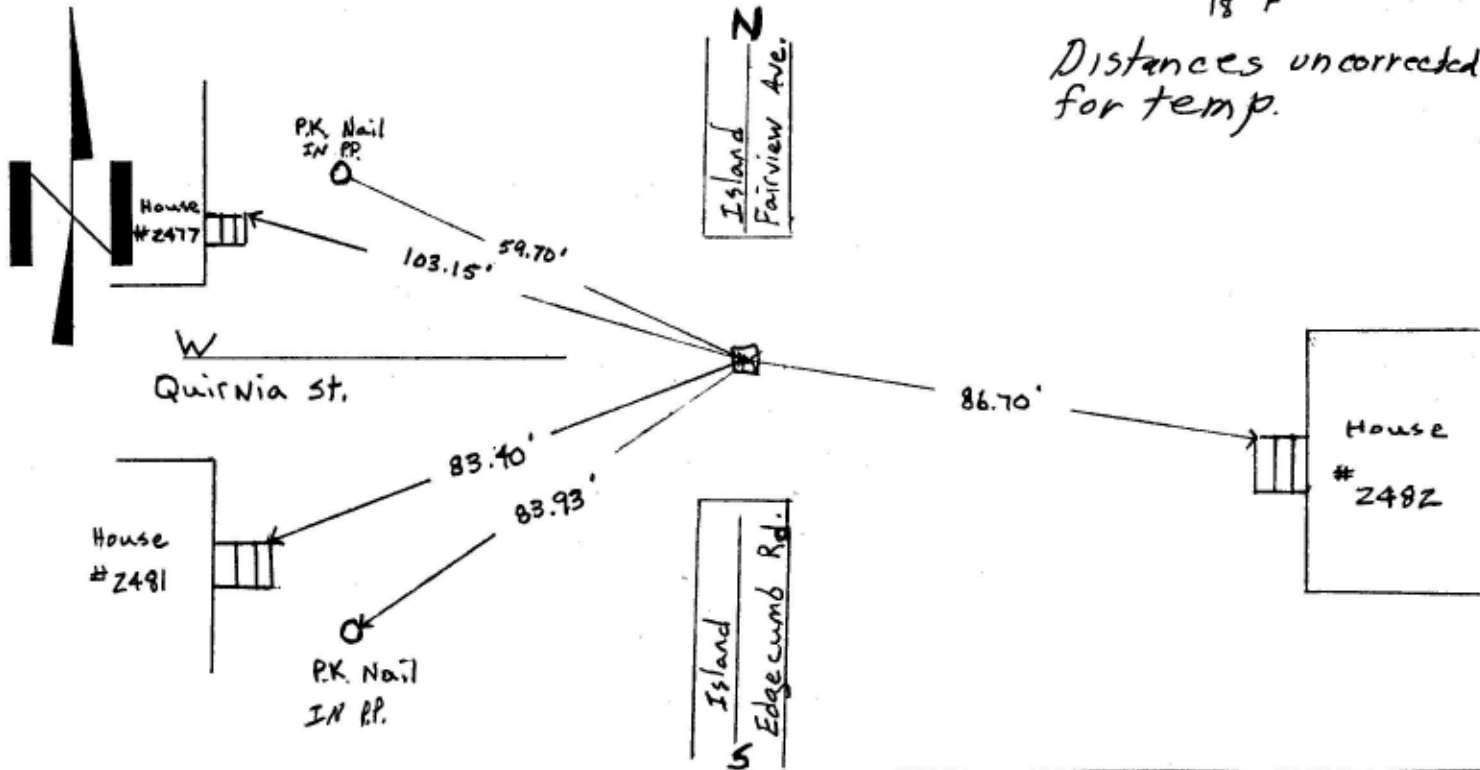

Statement of evidence relative to this corner location is on back of page.

I hereby certify that this document and the data contained herein was prepared by me or under my supervision.

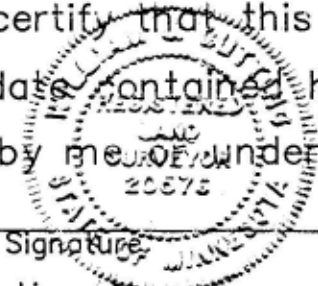

Signature _____

date Jan 14 1993

Registration No. _____

Land Surveyor Professional Engineer

Office of the Register of Deeds
County of _____

I hereby certify that this document was filed in the Reg. of Deeds office at _____ M.

on the _____ day of _____ A.D., 19____

Register of Deeds _____ By _____

DOCUMENT NO. _____

Scanned 5/27/99