

CERTIFICATE OF LOCATION OF GOVERNMENT CORNER

SECTION _____ Corner of Section 22, Township 28, Range 23, 4th P.M.


STATE OF MINNESOTA, County of RAMSEY

At the corner location shown on the sketch:

- On 9/25/95 found a GRANITE MONT. 0.5' BELOW GRADE
DATE
- left monument as found, lowered monument, removed monument (explain)
- On _____ placed a _____
DATE

SKETCH OF REFERENCE TIES

J. M. & crew.

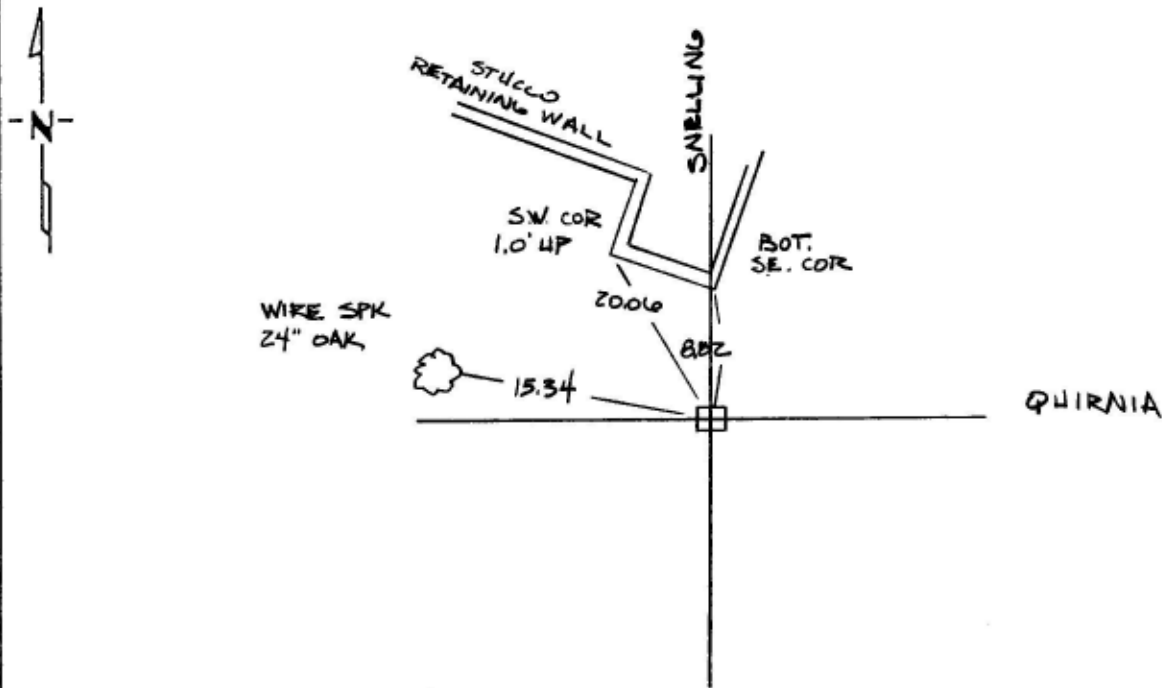

Statement of evidence relative to this corner location is on back of page.

I hereby certify that this document and the data contained herein was prepared by me or under my direct supervision.

William J. Cutting
SIGNATURE DATE 20/20/95

- Registration No. _____
- Land Surveyor, Professional Engineer
 - County Surveyor, County Engineer

OFFICE OF THE COUNTY RECORDER

County of _____

I hereby certify that this document was filed in the Co. Recorders office at _____ .M. on the _____ day of _____ A.D., 19 _____

County Recorder _____

By _____, Deputy

DOCUMENT NO. _____