#277 0277-1302-A

CERTIFICATE OF LOCATION OF GOVERNMENT CORNER

CENTER Corner of Section 21, Township 28, Range 23, P.M.

STATE OF MINNESOTA, County of Ramsey

At the corner location shown on the sketch:

☐ On 3-1-91 found a MH.

☐ left mon. as found ☐ lowered mon. ☐ removed mon.(explain)

☐ On ___ placed a ___

SKETCH OF REFERENCE TIES

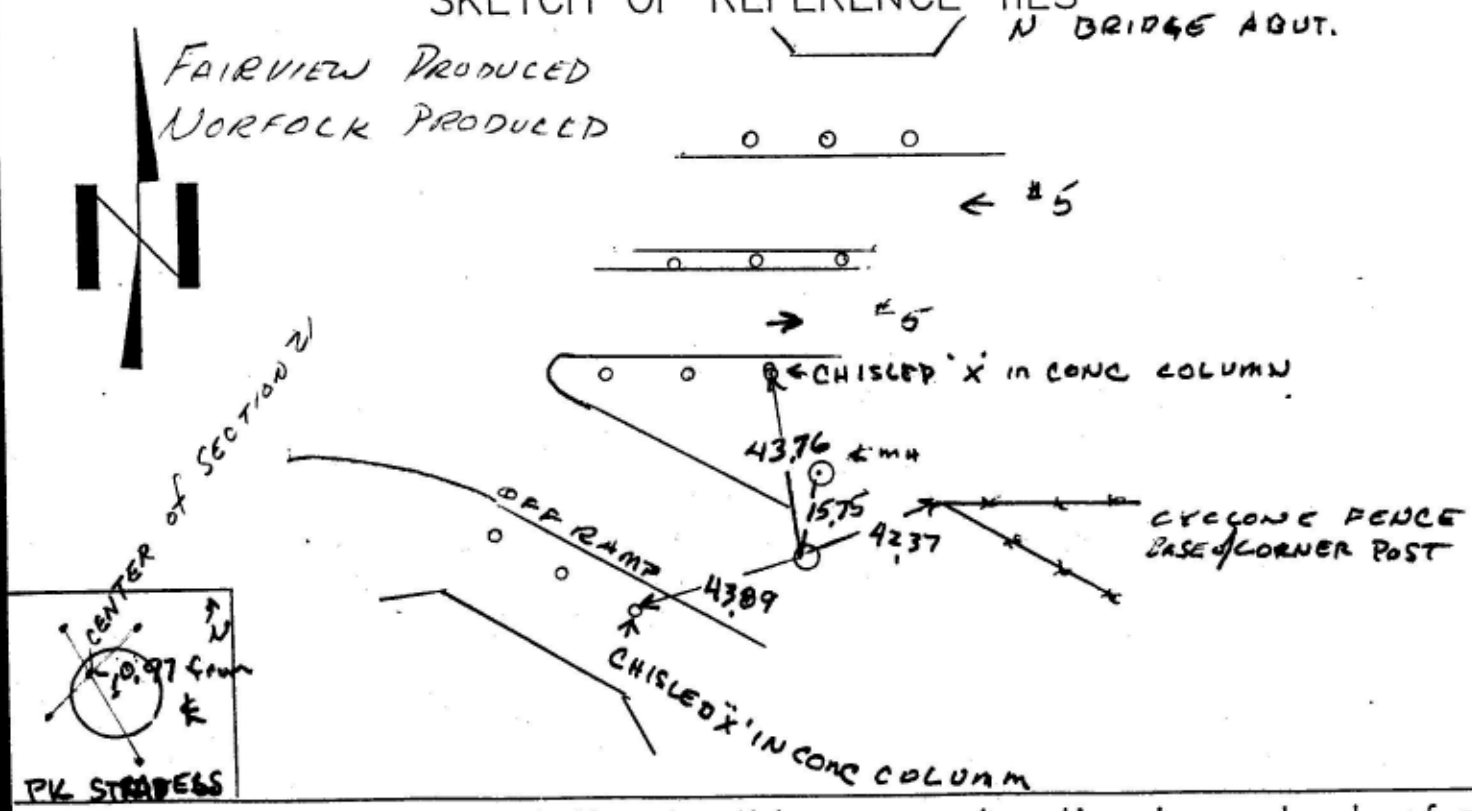

Statement of evidence relative to this corner location is on back of page.

I hereby certify that this document and the date contained herein was prepared by me or under my supervision.

William J Cutting March 1 1991
Signature date

Registration No. 20576

☐ Land Surveyor ☐ Professional Engineer

☐ County Surveyor ☐ County Engineer

Office of the Register of Deeds

County of ___

I hereby certify that this document was filed in the Reg.of Deeds office at ___.M.

on the day of ___ A.D.,19__

Register of Deeds ___ By ___

DOCUMENT NO. ___

Scanned 3/27/99