

CERTIFICATE OF LOCATION OF GOVERNMENT CORNER

CITY MON. NO. 1260

OLD INDEX NO. _____

MC Right Bank ^{COMMON TO} Corner of Sections 12 Township 28 Range 23, 4 P.M.
MISSISSIPPI RIVER

STATE OF MINNESOTA, County of Ramsey


At the corner location shown on the sketch:

On JAN. 30, 2002 found a CIM (mc) .30 BELOW GRADE
date

left monument as found lowered monument removed monument (explain)

On JAN. 30, 2002 placed a _____
date

SKETCH OF REFERENCE TIES

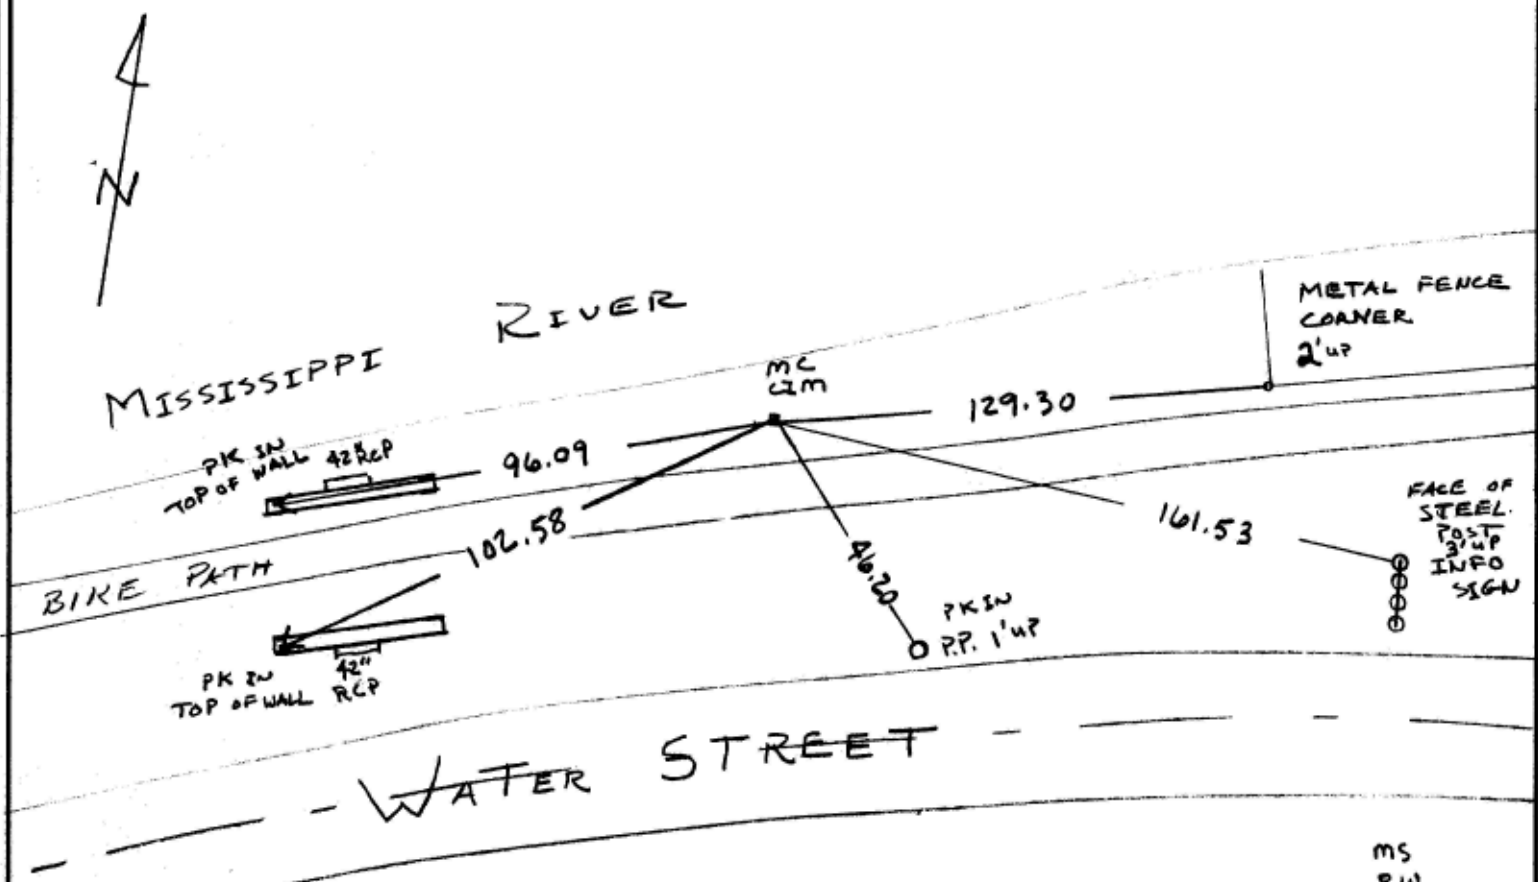

Statement of evidence relative to this corner is available from the St. Paul Public Works Dept., Survey Division

I hereby certify that this document and the data contained herein was prepared by me or under my direct supervision.

Office of The County Recorder, County of Ramsey

I hereby certify that this document was filed in the county
Recorders office at _____ M. on the _____ day of _____

County Recorder _____

By _____, Deputy

DOCUMENT NUMBER _____

Jeffrey J. Evans 2/4/02
SIGNATURE DATE

Registration No. 13144

Land Surveyor County Surveyor

Professional Engineer

Chief Surveyor, City of St. Paul