

CERTIFICATE OF LOCATION OF GOVERNMENT CORNER

MC Corner of Section 20/17, Township 28, Range 23, P.M.


STATE OF MINNESOTA, County of RAMSEY

At the corner location shown on the sketch:

- On _____ found a _____
- left mon. as found lowered mon. removed mon.(explain)
- On 17 JAN 91 placed a Re. BAR.

SKETCH OF REFERENCE TIES

HIDDEN FALLS PARK

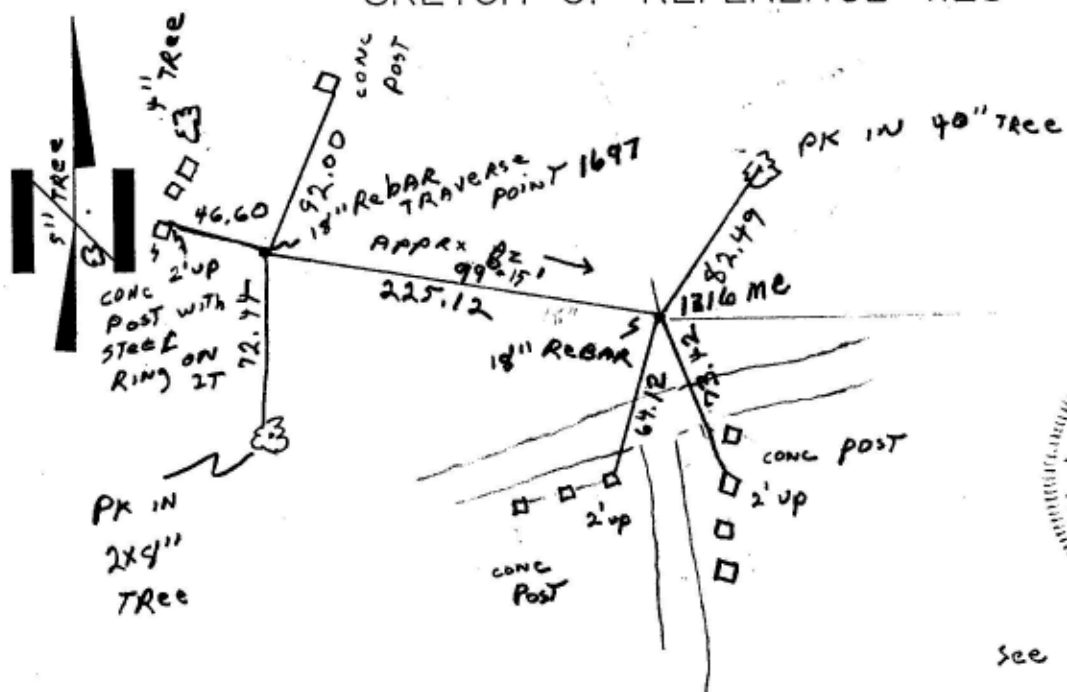

APPX E RAMLOW Produced



see FB 1673A p78
FB 1676C p77

Statement of evidence relative to this corner location is on back of page.

I hereby certify that this document and the date contained herein was prepared by me or under my supervision.

William J Cutting Signature 1-22-1991 date

Registration No. 20576

- Land Surveyor Professional Engineer
- County Surveyor County Engineer

Office of the Register of Deeds
County of _____

I hereby certify that this document was filed in the Reg. of Deeds office at _____ M.

on the _____ day of _____ A.D., 19____
Register of Deeds _____ By _____

DOCUMENT NO. _____

Scanned 6/11/99