

OFFICE COPY

2374-XXXX-A


(CITY) Index No. 192 2374

CERTIFICATE OF LOCATION OF GOVERNMENT CORNER

1/4 Corner of Section 9, Township 28, Range 23, _____ P.M.
STATE OF MINNESOTA, County of RAMSEY

At the corner location shown on the sketch:

- On JULY 29, 1994 found a CAST IRON MONT. AT GRADE
DATE
- left monument as found, lowered monument, removed monument (explain)
- On _____ placed a _____
DATE

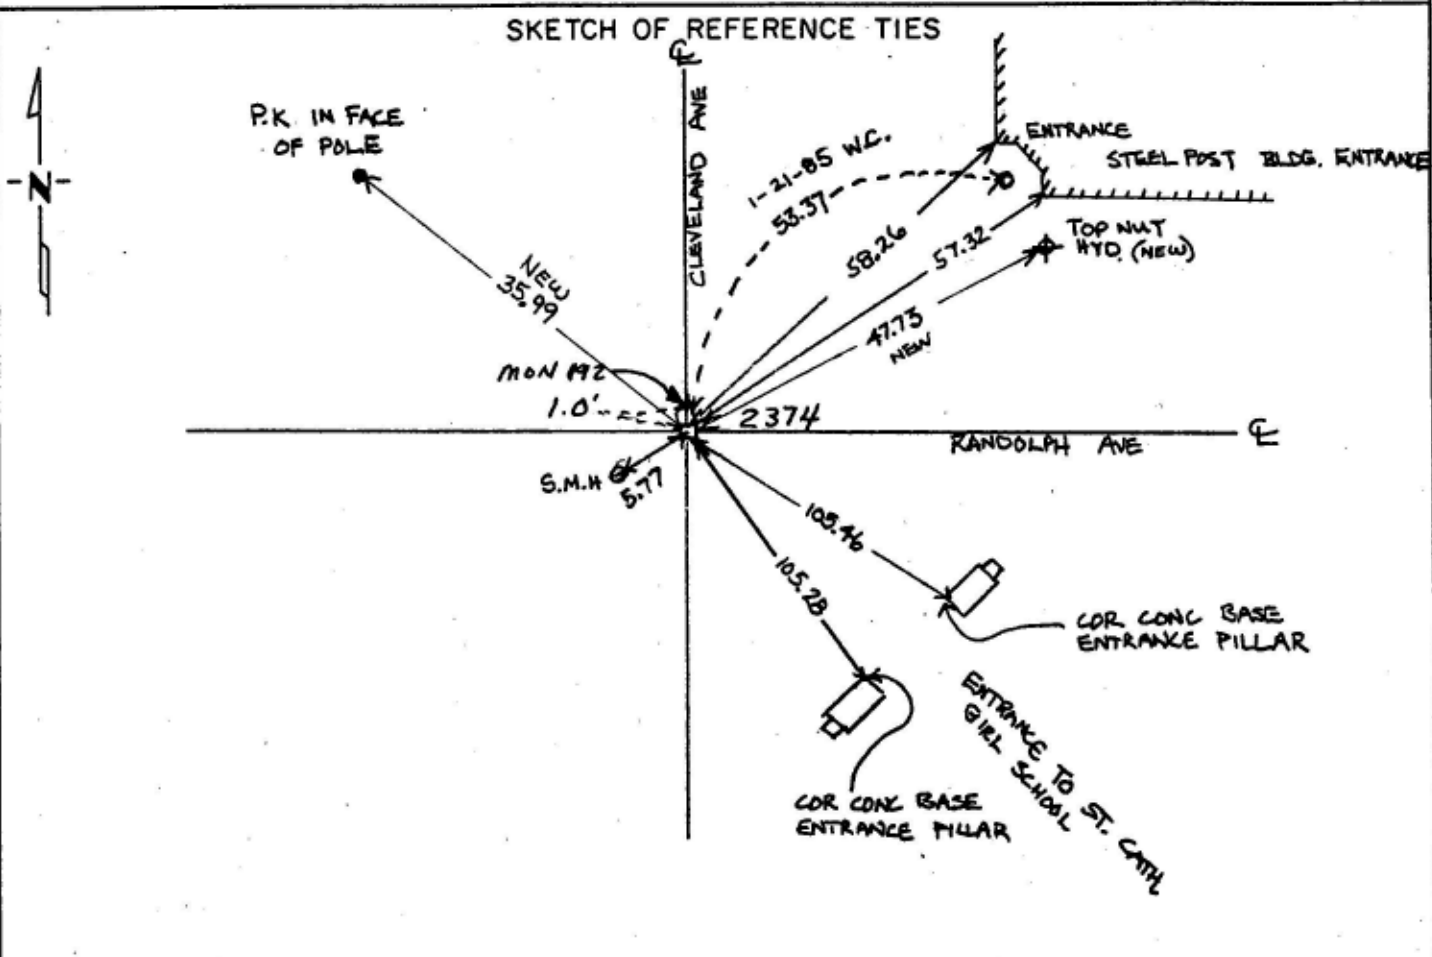

SKETCH BY: M WASSMAN ON OCT. 3, 1994 FIELD TIES BY: ME, D.N., R.S., BSM 7/29/94

Statement of evidence relative to this corner location is on back of page.

I hereby certify that this document and the data contained herein was prepared by me or under my direct supervision.

SIGNATURE DATE

Registration No. _____
 Land Surveyor, Professional Engineer
 County Surveyor, County Engineer

OFFICE OF THE COUNTY RECORDER
County of _____

I hereby certify that this document was filed in the Co. Recorders office at _____ .M. on the _____ day of _____ A.D., 19 _____

County Recorder _____

By _____, Deputy

DOCUMENT NO. _____