

CERTIFICATE OF MONUMENT LOCATION

CITY MON. NO. 2405

OLD INDEX NO. 1342

WITNESS Corner ^{to} the N. 1/4 Qtr. of Section 26 Township 29 Range 23


STATE OF MINNESOTA, County of Ramsey

At the corner location shown on the sketch:

On Sept 9, 2002 found a G.M. 0.20' below grass grade

left monument as found lowered monument removed monument (explain)

On Sept 9, 2002 placed a magnet in center monument

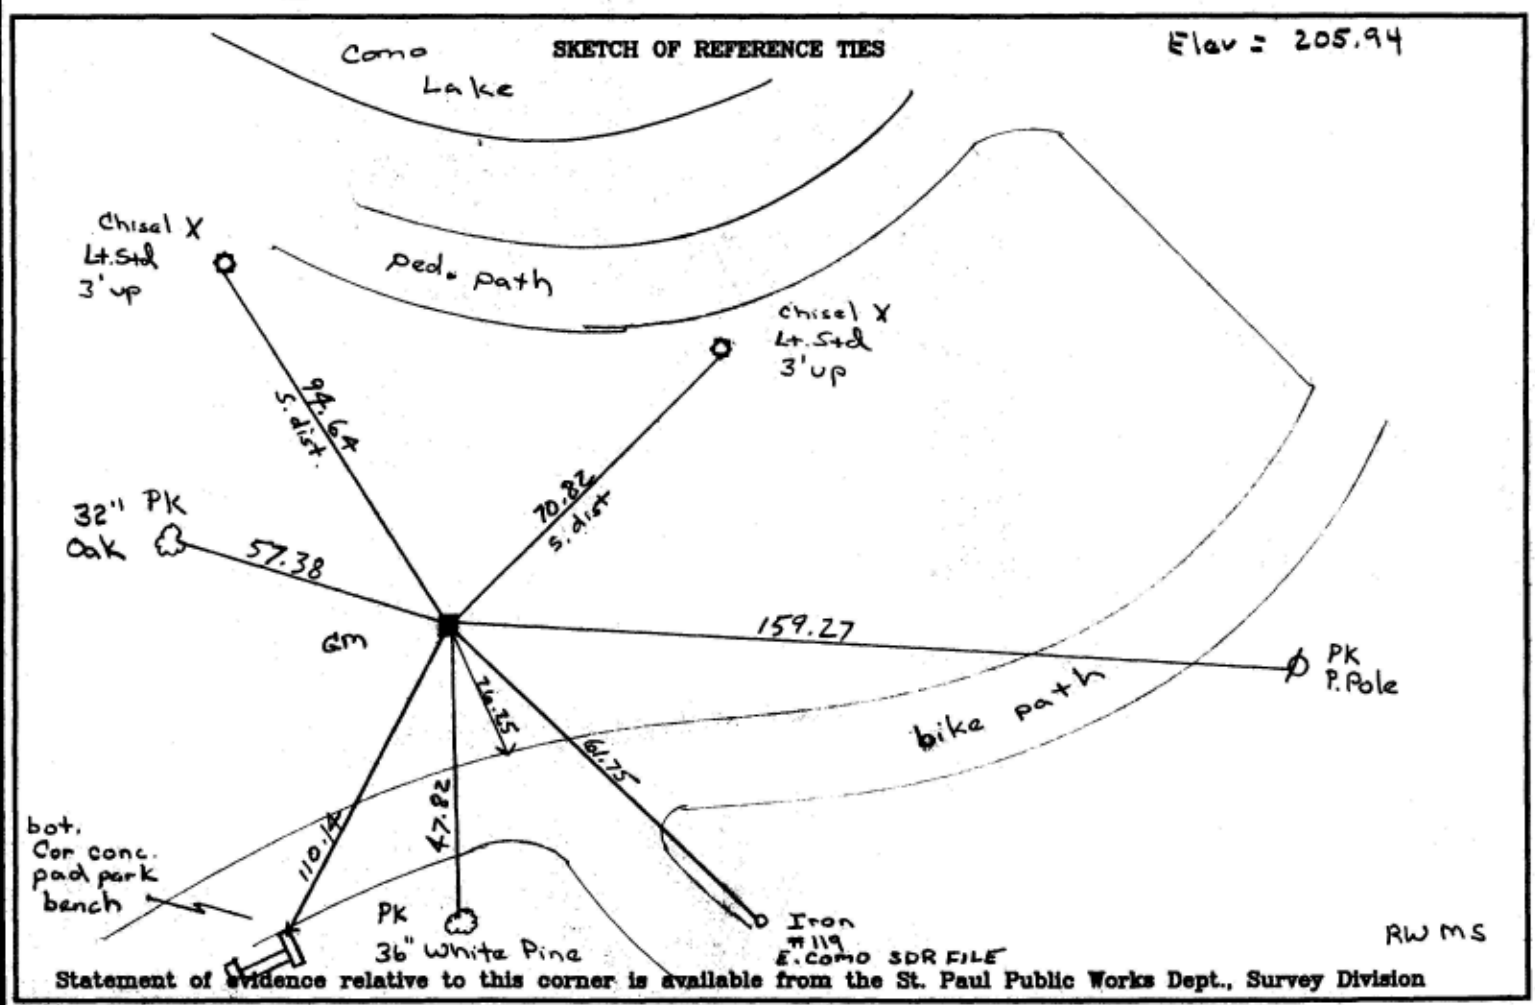

I hereby certify that this document and the data contained herein was prepared by me or under my direct supervision.

Jeffrey L. Jones 9/09/02
Registration No. 13144

- Land Surveyor County Surveyor
- Professional Engineer
- Chief Surveyor, City of St. Paul

Office of The County Recorder, County of Ramsey

I hereby certify that this document was filed in the county Recorders office at _____ M. on the _____ day of _____

County Recorder _____

By _____, Deputy

DOCUMENT NUMBER _____