

# MINNESOTA DEPARTMENT OF TRANSPORTATION CERTIFICATE OF LOCATION OF GOVERNMENT CORNER

EAST QUARTER CORNER, Section 21, Township 29 North, Range 23 West,  
4th Principal Meridian Survey, Ramsey County, Minnesota.


At the corner location shown on the sketch:

- On JULY 25, 2017 found A DAMAGED BRASS DISK (MILLED OVER)
- left monument as found,     lowered monument,     removed monument (explain)

---

- On JULY 25, 2017 ~~placed a~~ GROUND DOWN BRASS DISK TO A SMOOTH SURFACE, PUNCHED AND STAMPED DISK "EQ 21"

Corner reference ties measured on JULY 25, 2017  
Statement of evidence relative to this corner location is on back of page.

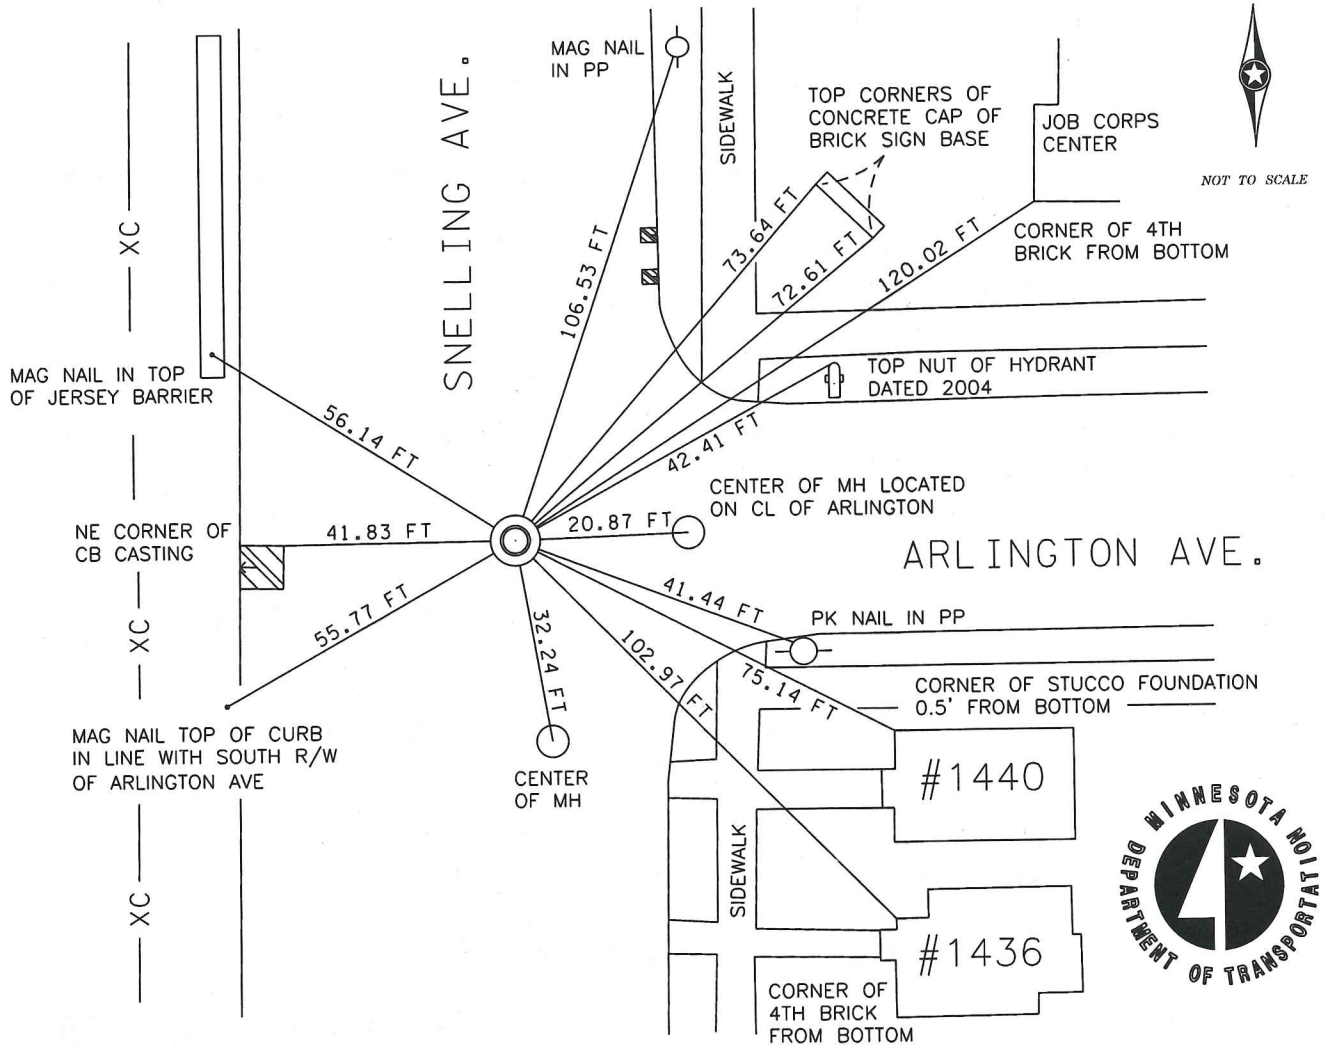

Tie distances are horizontal distances measured with a total station EDM.

I hereby certify that this document and the data contained herein was prepared by me or under my direct supervision. I further certify that this document conforms to applicable portions of Minnesota State Statute 381.12.

*Michael D. Nelson*

Michael D. Nelson, Mn/DOT Surveys  
Minnesota License No. 49546

4/02/18  
Date



**East Quarter Corner, Section 21, T. 29 N. - R. 23 W.**

Statement of Evidence

- 1847 Unknown day, November. Isaac N Higbee deputy surveyor set post. Tied to 2 BTs. See IH p.094-095 2923
- 1891 Unknown day, March. Monument set by J H Armstrong See FB 345 p.22,24 See Old Index Book, Entry 2270
- 1891 Unknown day, March. Placed ties. See FB 345 p.22
- 1891 Unknown day April. Monument set by J H Armstrong see Standard Map of Sec 21-29-23 See Old Index Book, Entry 2684
- 1988 Unknown day, May. CIM set in concrete
- 1989 Unknown date. Historic, one time only GPS survey = S605
- 1994 August 25. Elev 252.56 ft on drill hole. See 97adj.pts, 1994/hoyt.org/hoyt.fbk (loop 002) Digital-Adj
- 1995 September 21. Fd drill hole (marked for painting target for 1995 aerial)
- 2000 March 17. Drill hole in concrete pavement (marked for painting target for 2000 aerial)
- 2002 January 3. Elev 252.56 ft on drill hole in concrete pavement N bound drive lane on Snelling Ave. See FB 1736 p.9
- 2002 September 28. Fd drill hole in concrete pavement. Placed ties. Set bronze cap 0.02 below concrete pavement. See CofL 0026-2684-A
- 2012 October 4. Found Bronze Cap at street grade. Photos taken.
- 2017 July 25. MNDOT personnel found brass disk damaged from road repair project (milled). MNDOT personnel ground down brass disk to a smooth surface, punched, and stamped disk "EQ 21". Reference ties were taken as shown on the front of this certificate.