

# MINNESOTA DEPARTMENT OF TRANSPORTATION CERTIFICATE OF LOCATION OF GOVERNMENT CORNER

EAST QUARTER CORNER , Section 12 , Township 28 North, Range 23 West,  
4th Principal Meridian Survey, Ramsey County, Minnesota.

At the corner location shown on the sketch:


On AUGUST 7, 2017 found 8" x 8" GRANITE STONE (CITY INDEX NO. 0200)

left monument as found,  lowered monument,  removed monument (explain)


On \_\_\_\_\_ placed a \_\_\_\_\_

Corner reference ties measured on AUGUST 7, 2017

Statement of evidence relative to this corner location is on back of page.

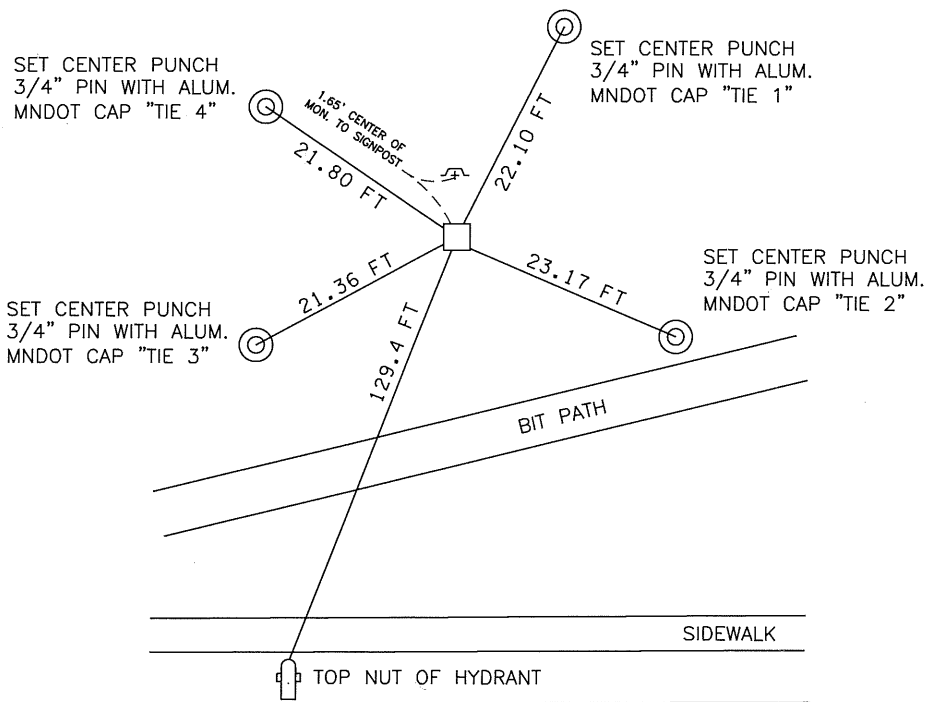

NOT TO SCALE

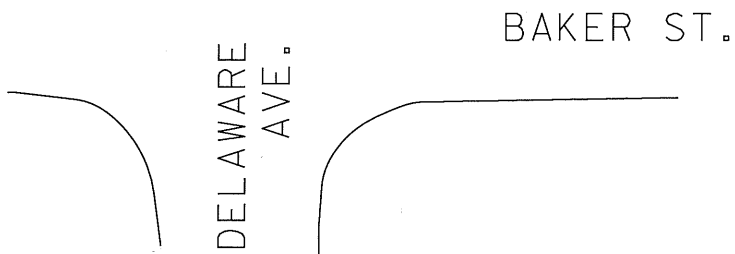

Tie distances are horizontal distances measured with a steel tape, temperature corrected.

I hereby certify that this document and the data contained herein was prepared by me or under my direct supervision. I further certify that this document conforms to applicable portions of Minnesota State Statute 381.12.

Matthew J. Wernet  
Matthew J. Wernet, MnDOT Surveys  
Minnesota License No. 41888

09/05/2018  
Date

**St. Paul Monument 0200, Section 12, T. 28 N. - R. 23 W.**

**Statement of Evidence**

- 1853 July 8. Jesse T Jarrett deputy surveyor set post. Tied to 2 BTs. See JJ p.026-027 border
- 1890 Unknown day, March. Placed ties. See FB 320 p.3
- 1972 February 16. Fd GM to grade. See FB 1689A p.7
- 1985 December 27. Fd mon't at grade. See Yellow Tie Book.
- 1989 Unknown day, February. Located by traverse (single stub). See FB 1713 p.2
- 1991 April 2. Fd GM to grade.
- 2000 Unknown day, March. Fd GM at grade (placed fabric target for 2000 aerial)
- 2002 January 22. Elev 238.16 ft on GM 0.10 ft below grade. See FB 1736 p.11
- 2008 September 18. Elev 238.18 ft. on GM. See FB 1740 p.72
- 2012 November 14. Found GM 0.1 ft below surface grade. Photos taken. Position established by topo using Trimble S6 with RTK-VRS GPS control determined using Trimble R8. Elev. 238.02 ft.
- 2017 August 7. MnDOT personnel found granite monument in good condition. Reference ties were taken as shown on the front of this certificate.

**Summary and Conclusion:**

The granite monument was left undisturbed by MnDOT survey personnel. This Certificate of Location is a perpetuation of the found granite monument.