

# MINNESOTA DEPARTMENT OF TRANSPORTATION CERTIFICATE OF LOCATION OF GOVERNMENT CORNER

WITNESS CORNER \_\_\_\_\_, Section 8, Township 29 North, Range 23 West,  
4th Principal Meridian Survey, Ramsey County, Minnesota.


At the corner location shown on the sketch:

- On \_\_\_\_\_
- left monument as found,     lowered monument,     removed monument (explain)
- 
- On SEPTEMBER 8th, 2022 placed a CAST IRON MONUMENT ON THE EAST-WEST QUARTER LINE, 350' WEST OF E1/4 SECTION 8

Corner reference ties measured on SEPTEMBER 8TH, 2022

Statement of evidence relative to this corner location is on back of page.

Tie distances are horizontal distances measured with a total station EDM unless otherwise noted.

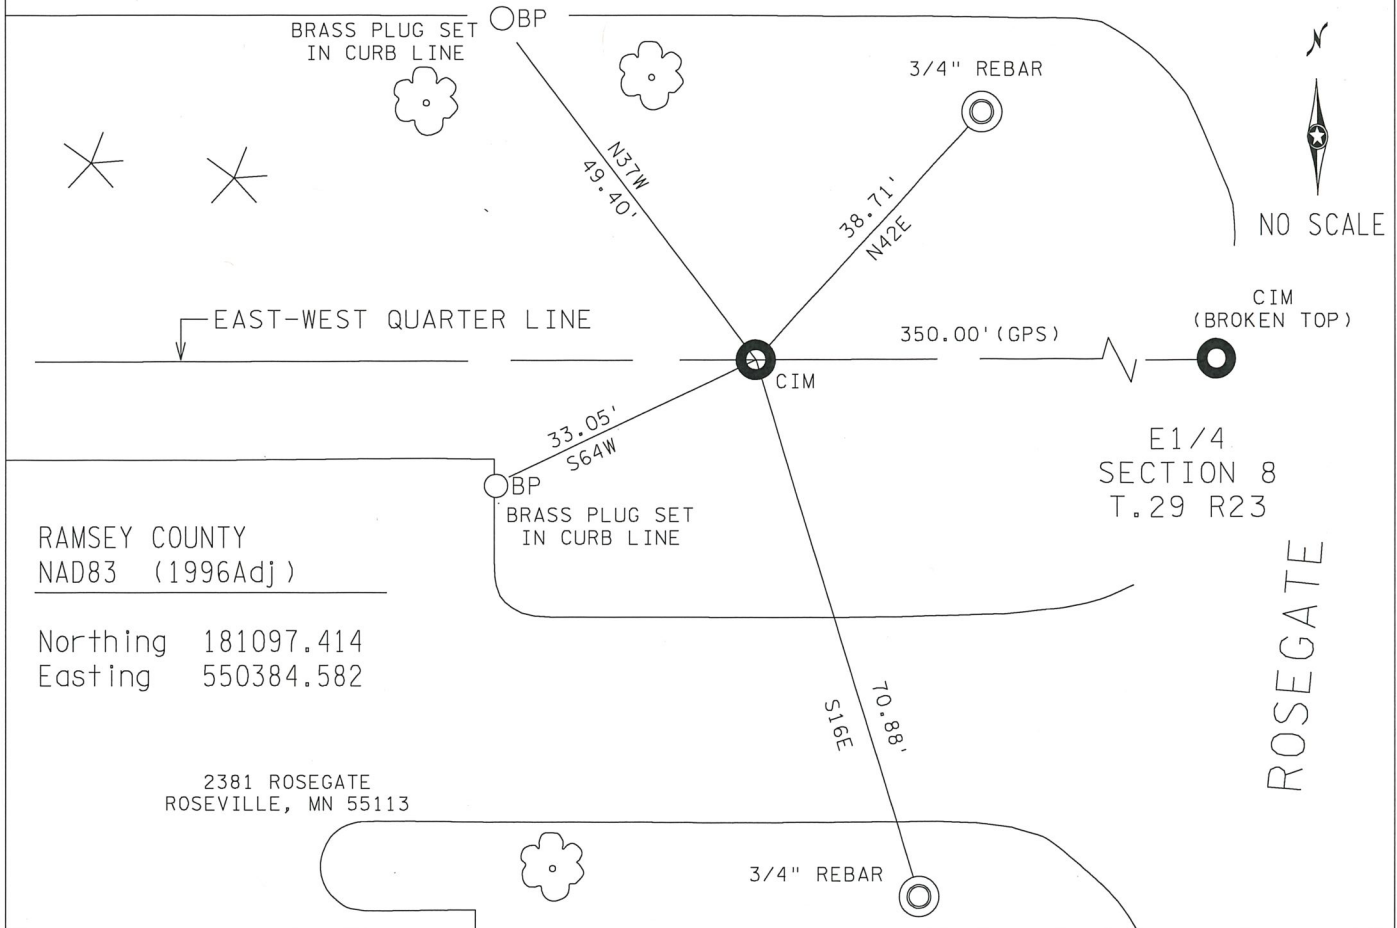

I hereby certify that this document and the data contained herein was prepared by me or under my direct supervision. I further certify that this document conforms to applicable portions of Minnesota State Statute 381.12.

Michael D. Nelson

4-24-2023

Michael D. Nelson, Mn/DOT Surveys  
Minnesota License No. 49546

Date