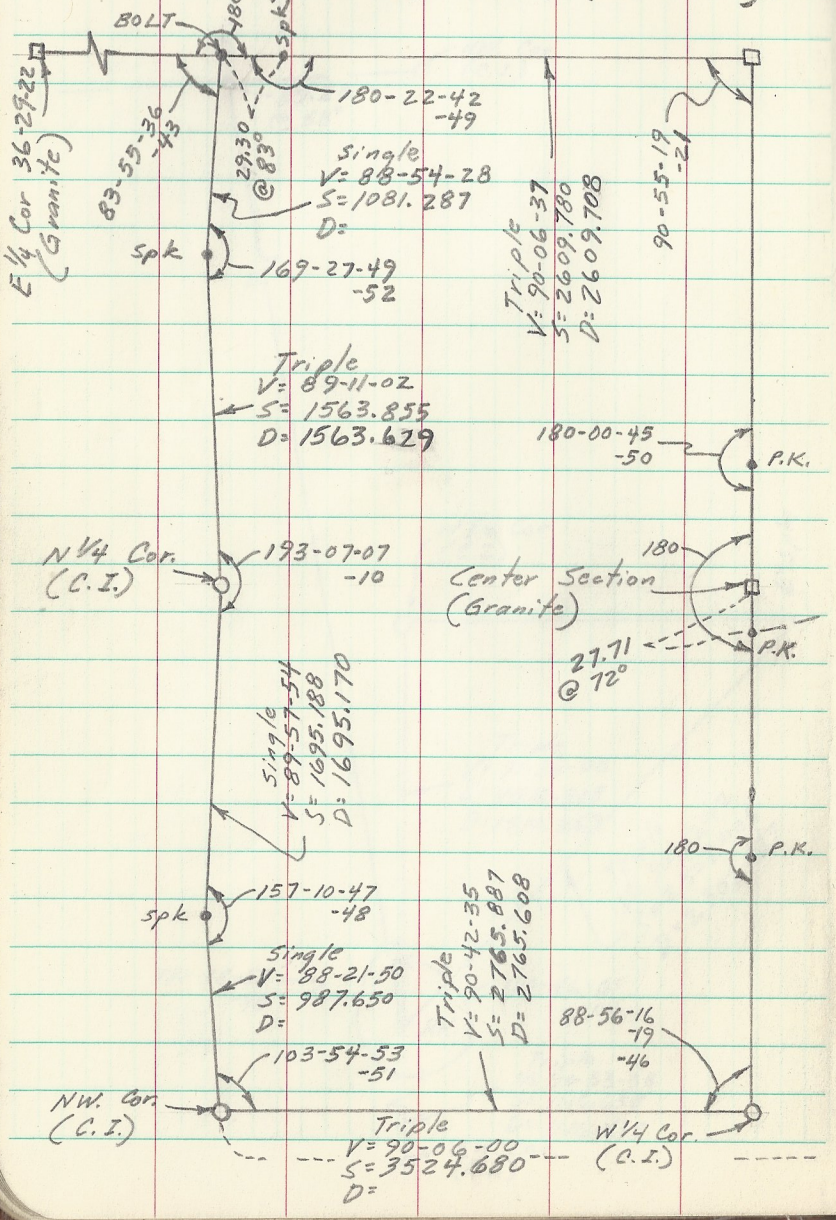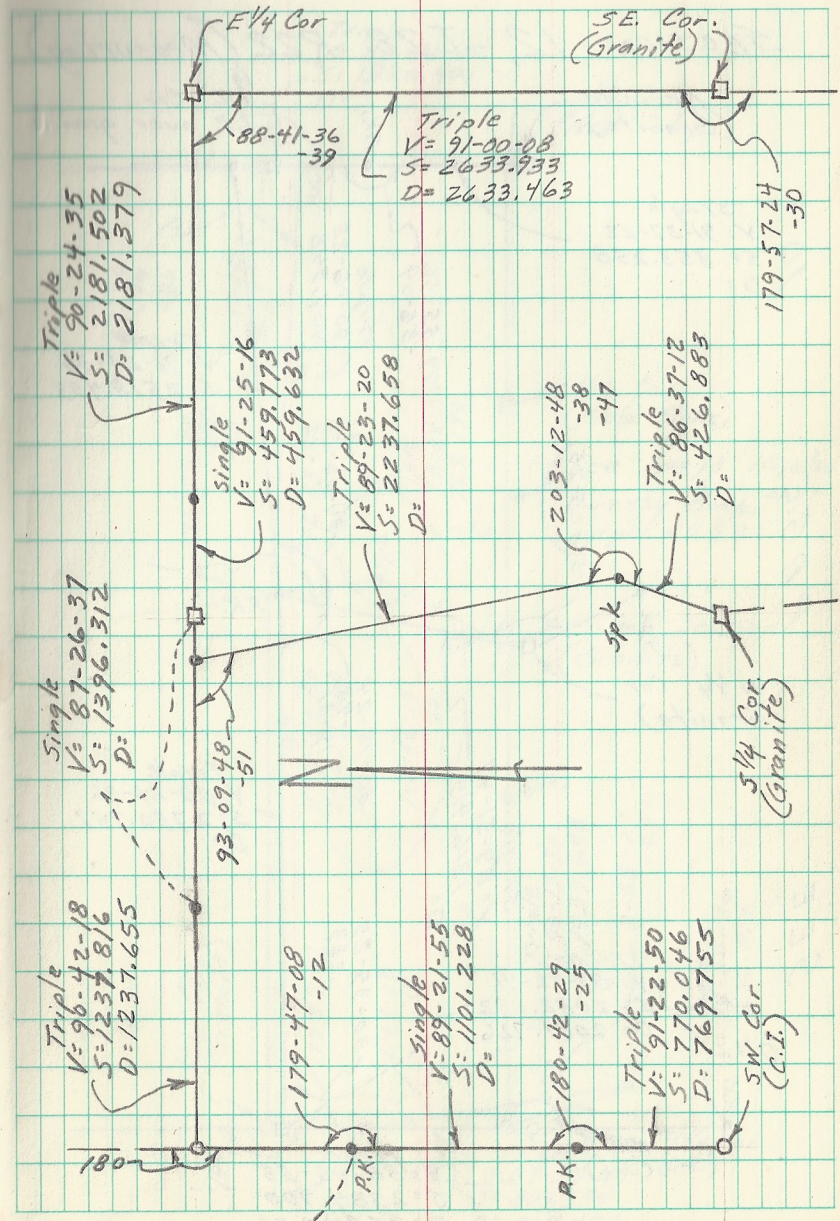SECTION 1, T28, R22 (Measuring)