



⑦

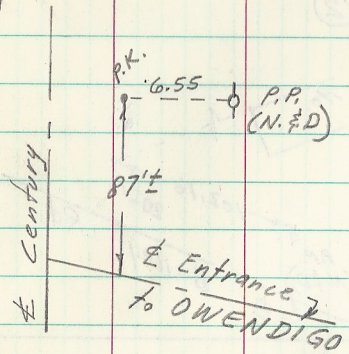

⑧

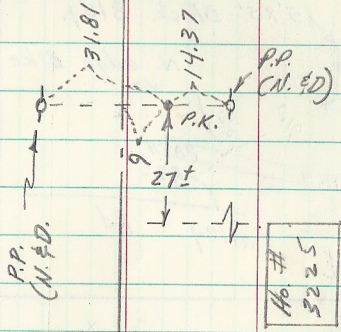

⑨

