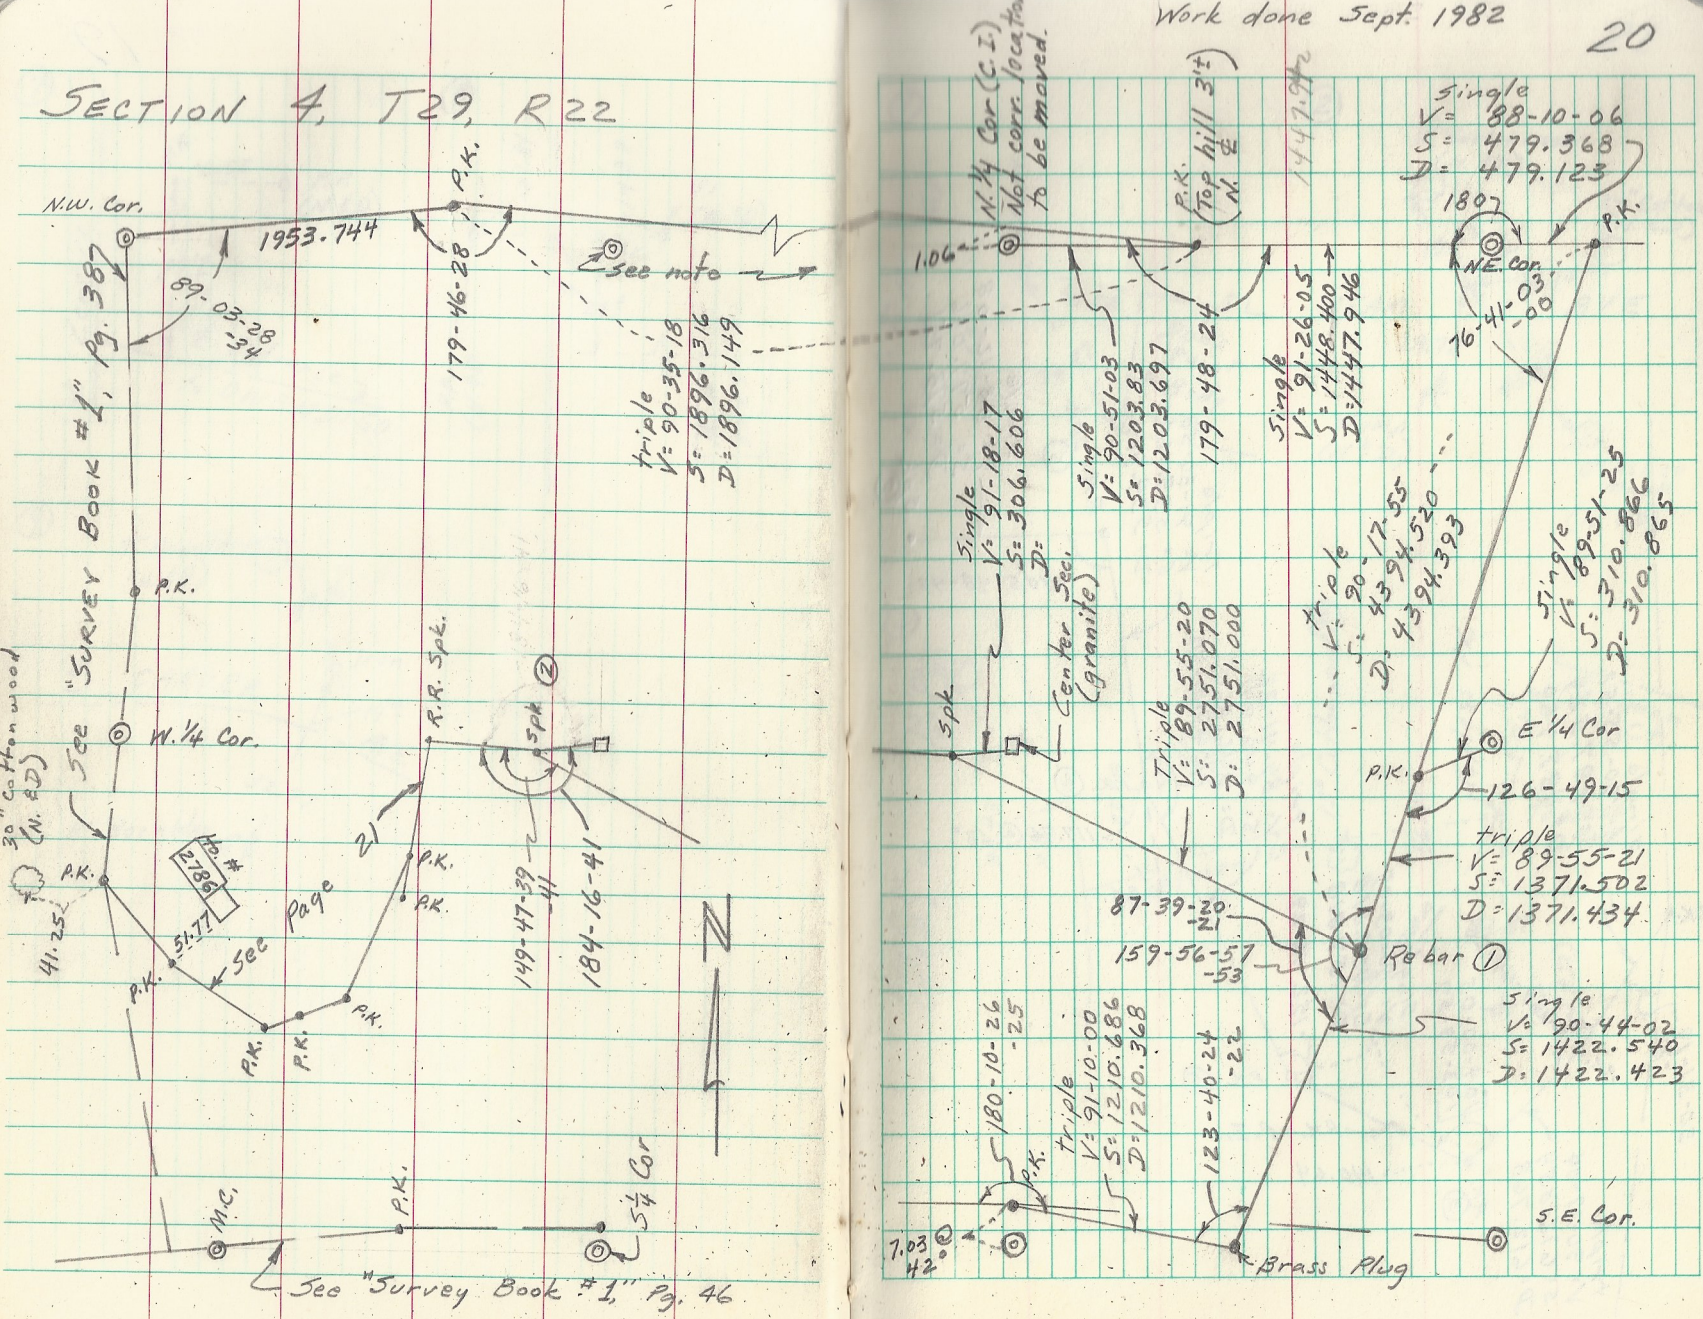SECTION 4, T29, R22