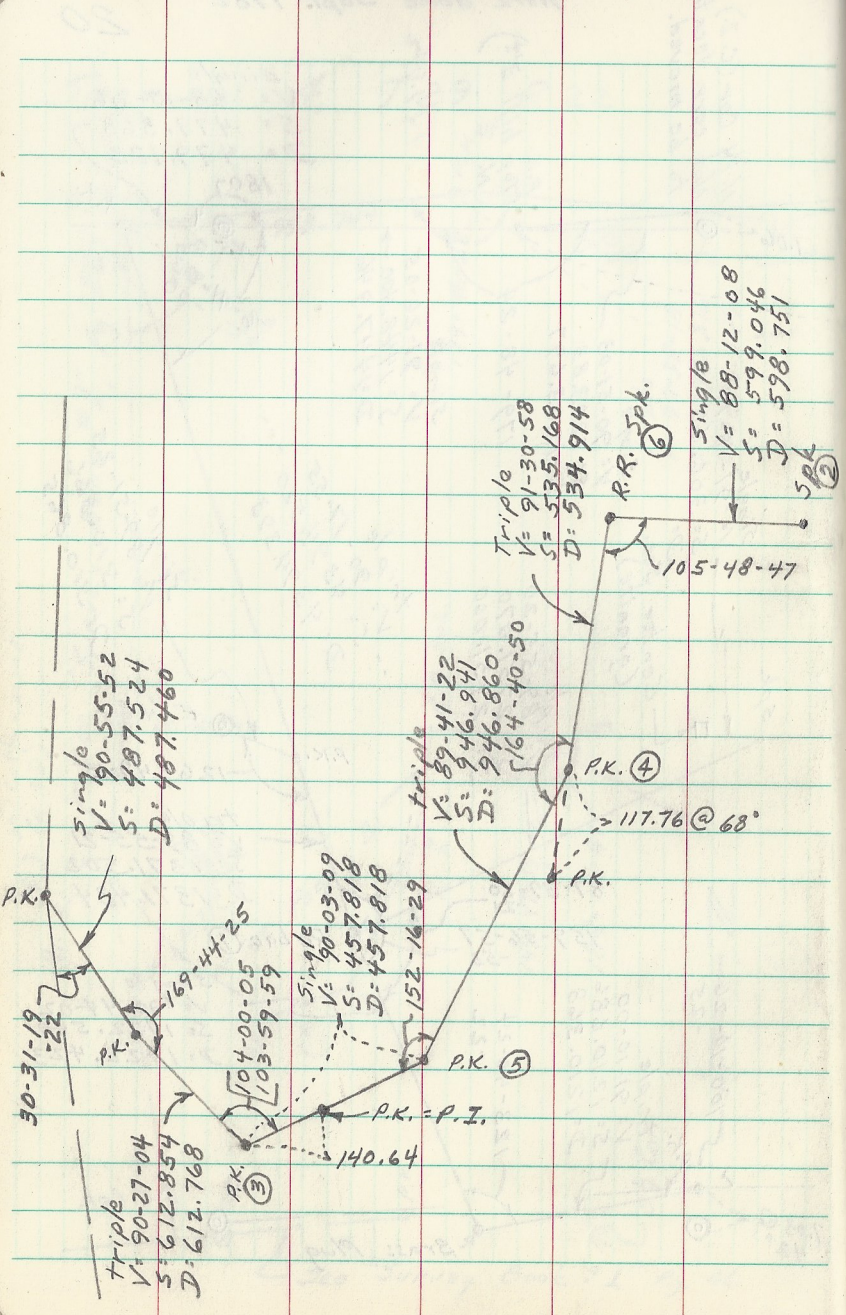

Triple
V: 90-27-04
S: 612.854
D: 612.768
P.K. ③
30-31-19
-22
P.K.
169-44-25
104-00-05
103-59-59
Single
V: 90-03-09
S: 457.818
D: 457.818
152-16-29
P.K. ⑤
P.K. = P.I.
140.64
Single
V: 90-55-52
S: 487.524
D: 487.460
triple
V: 89-41-22
S: 946.941
D: 946.860
164-40-50
P.K. ④
117.76 @ 68°
P.K.
Triple
V: 91-30-58
S: 535.168
D: 534.914
R.R. Spk. ⑥
105-48-47
Single
V: 88-12-08
S: 599.046
D: 598.751
Spk ②

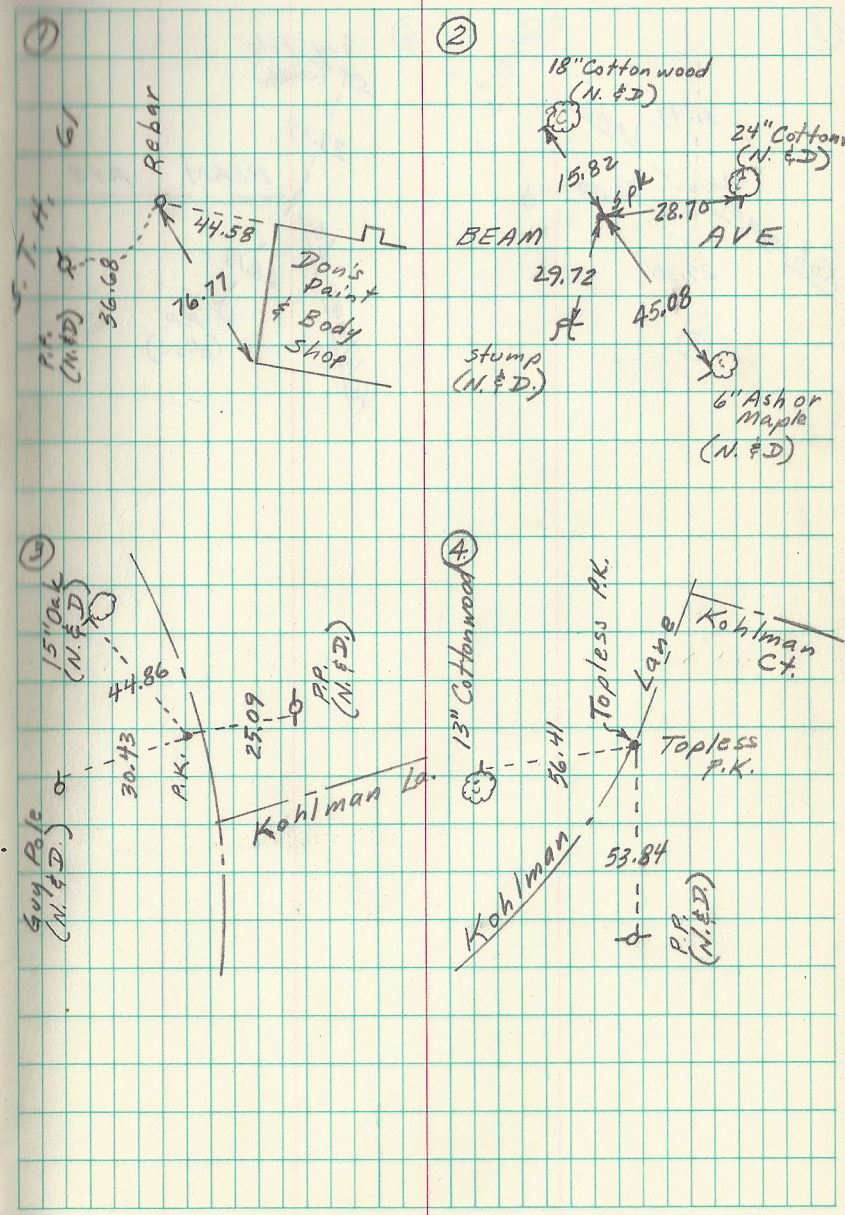

①
S.T.H. 61
Rebar
44.58
36.68
76.77
P.P. (N.&D)
Don's Paint & Body Shop
②
18" Cottonwood (N.&D)
24" Cottonwood (N.&D)
15.82
Spk
28.70
BEAM
AVE
29.72
45.08
Stump (N.&D.)
6" Ash or Maple (N.&D)
③
15" Oak (N.&D)
44.86
30.43
25.09
P.K.
P.P. (N.&D.)
Guy Pole (N.&D.)
Kohlman La.
④
13" Cottonwood
Topless P.K.
Lane
Kohlman Ct.
56.41
Topless P.K.
53.84
Kohlman
P.P. (N.&D.)