


5

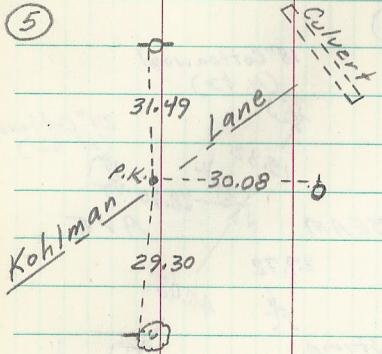

6

