


SECTION 24, T29, R22
(NORTH LINE)

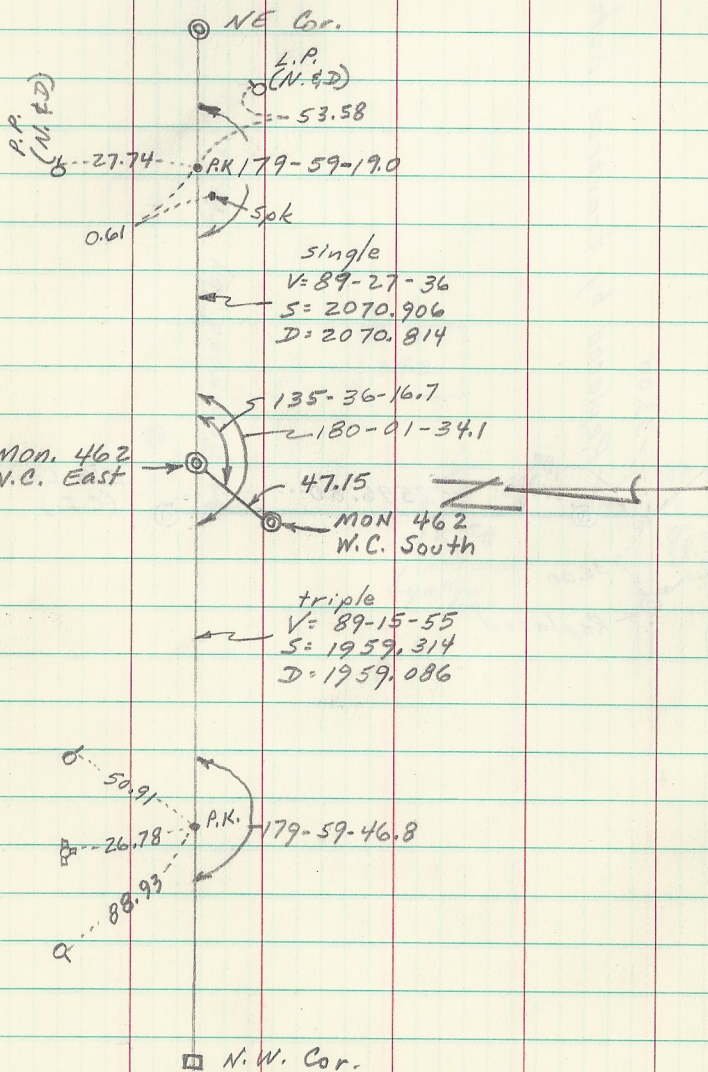

S. line (2-28-85)

(SOUTH LINE)

