


SECTION 33, T30, R23 (Measuring)

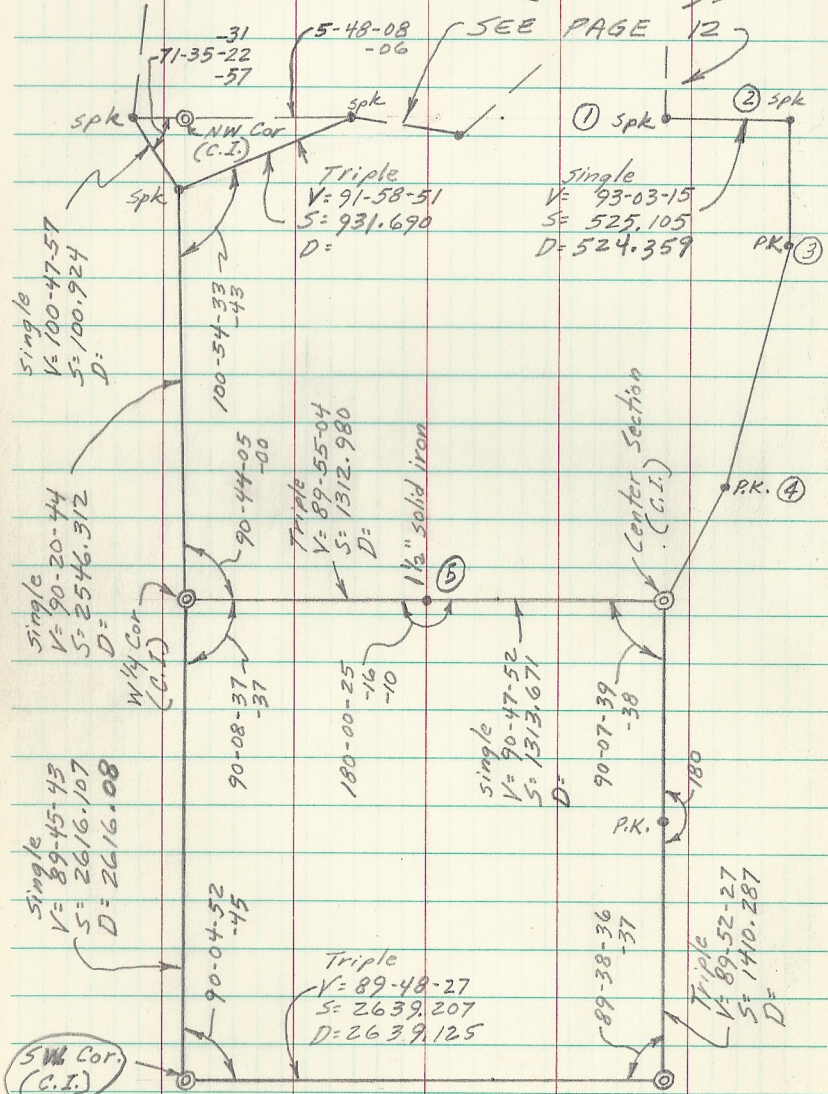

Granite mon. found
Feb. 1986; C.I. South
approx. 1 foot.

