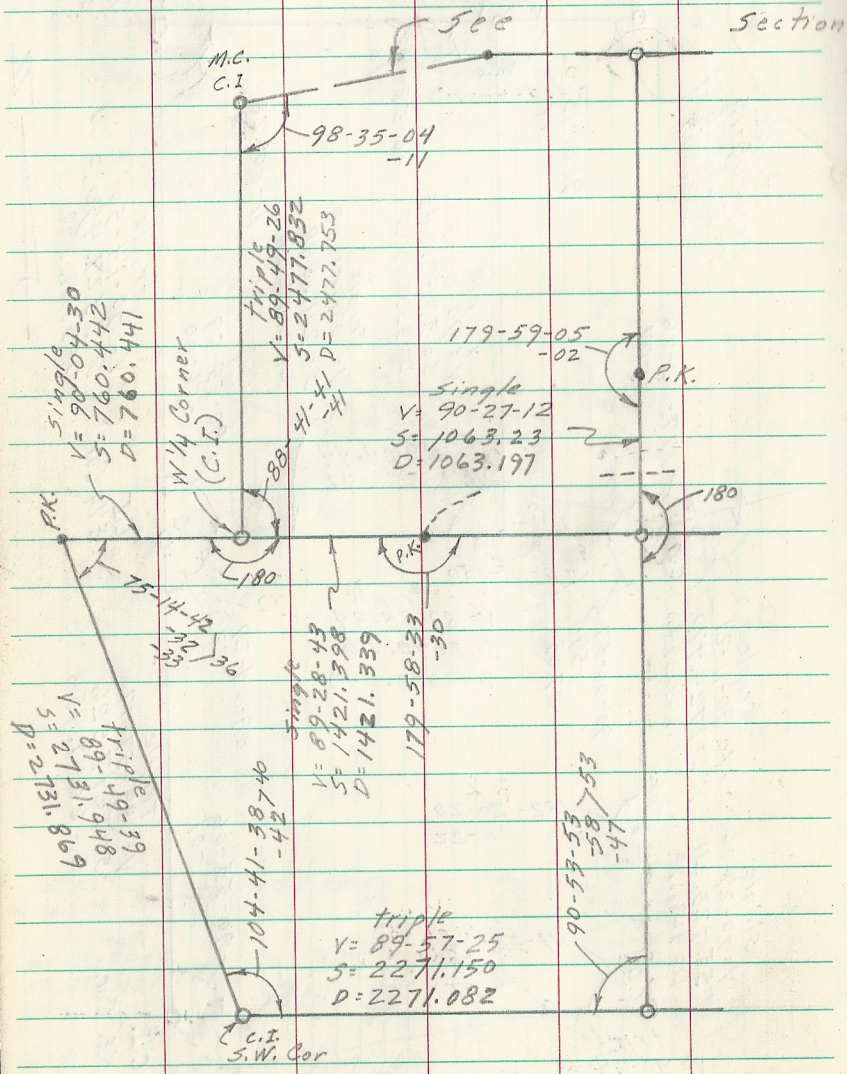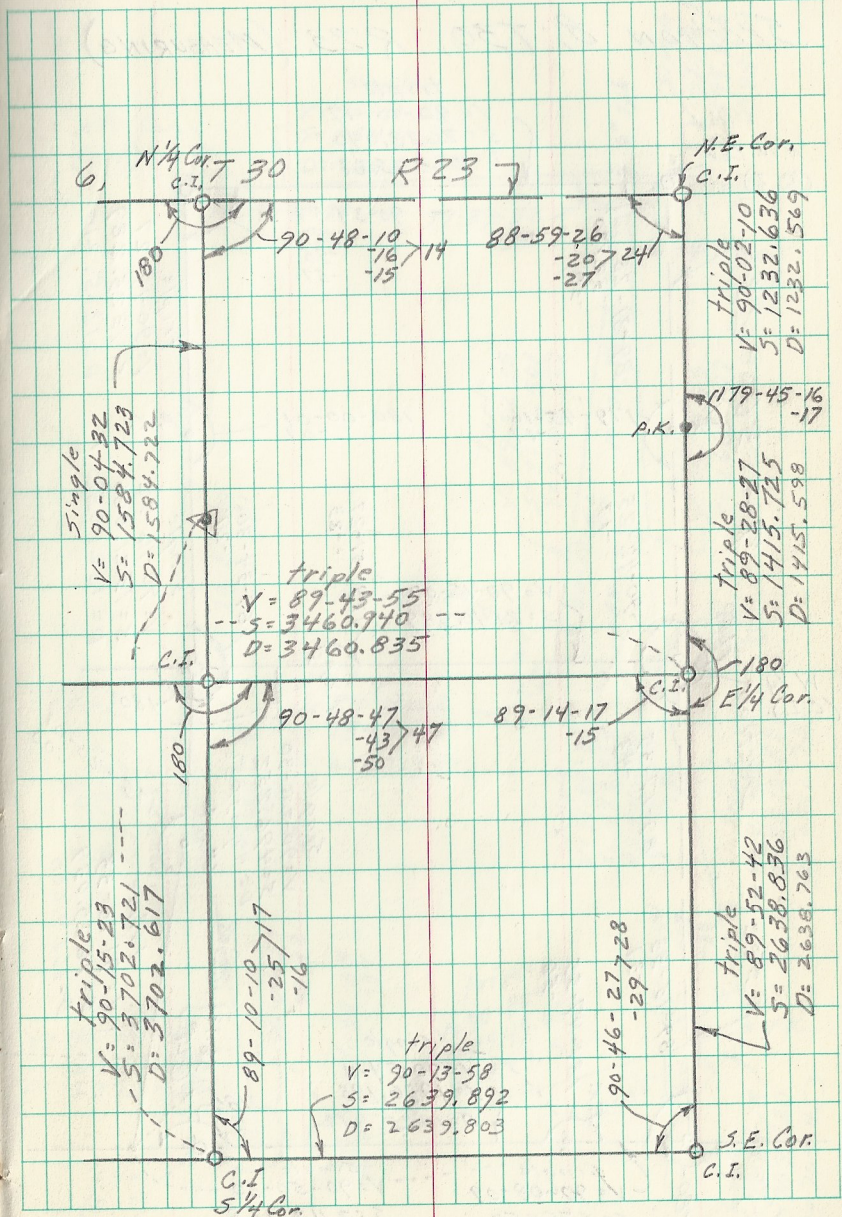SECTION 7, T 30, R 23 (MEASURING)