


SECTION 29, T30, R23 (Measuring)

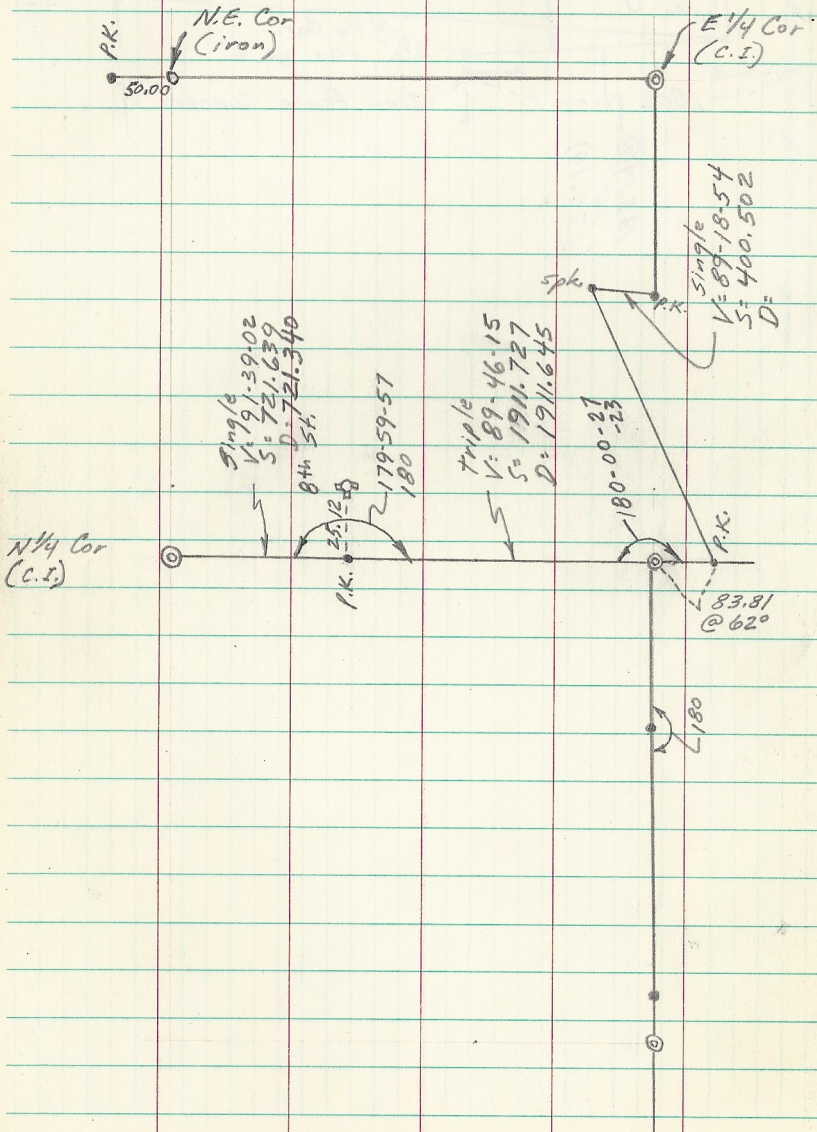

Sept. 1977

