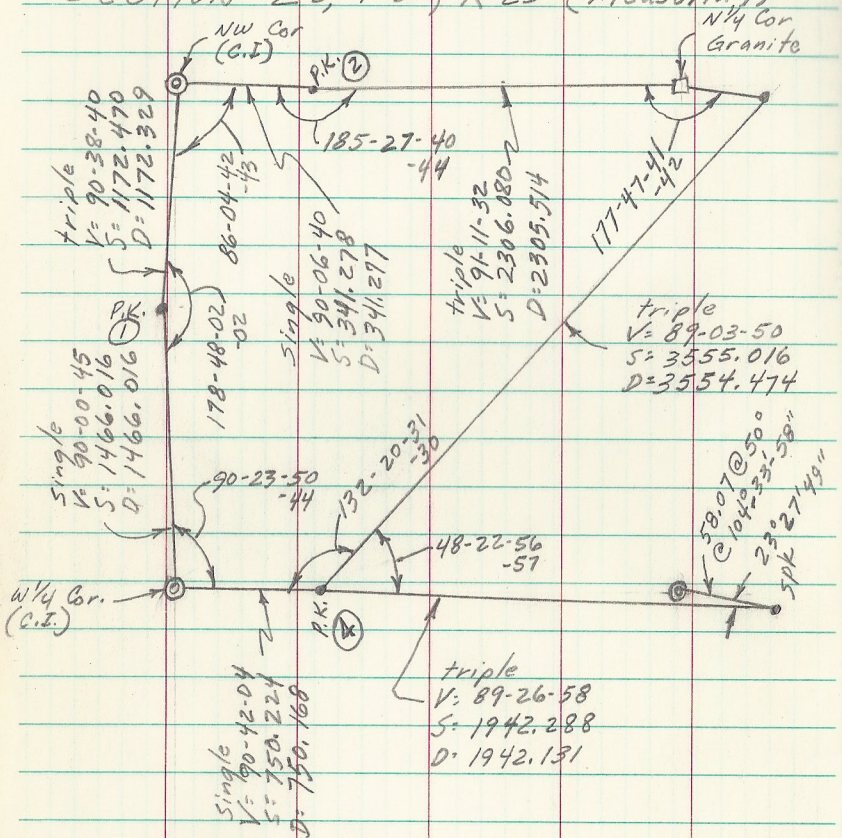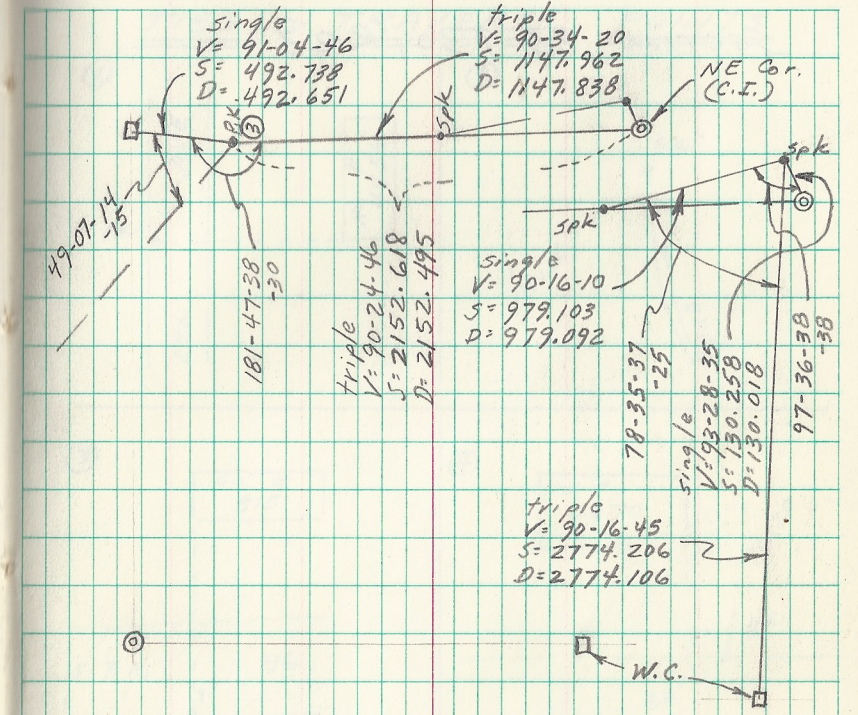SECTION 23, T30, R23 (Measuring)