


SECTION 2, T30, R23 (Measuring)

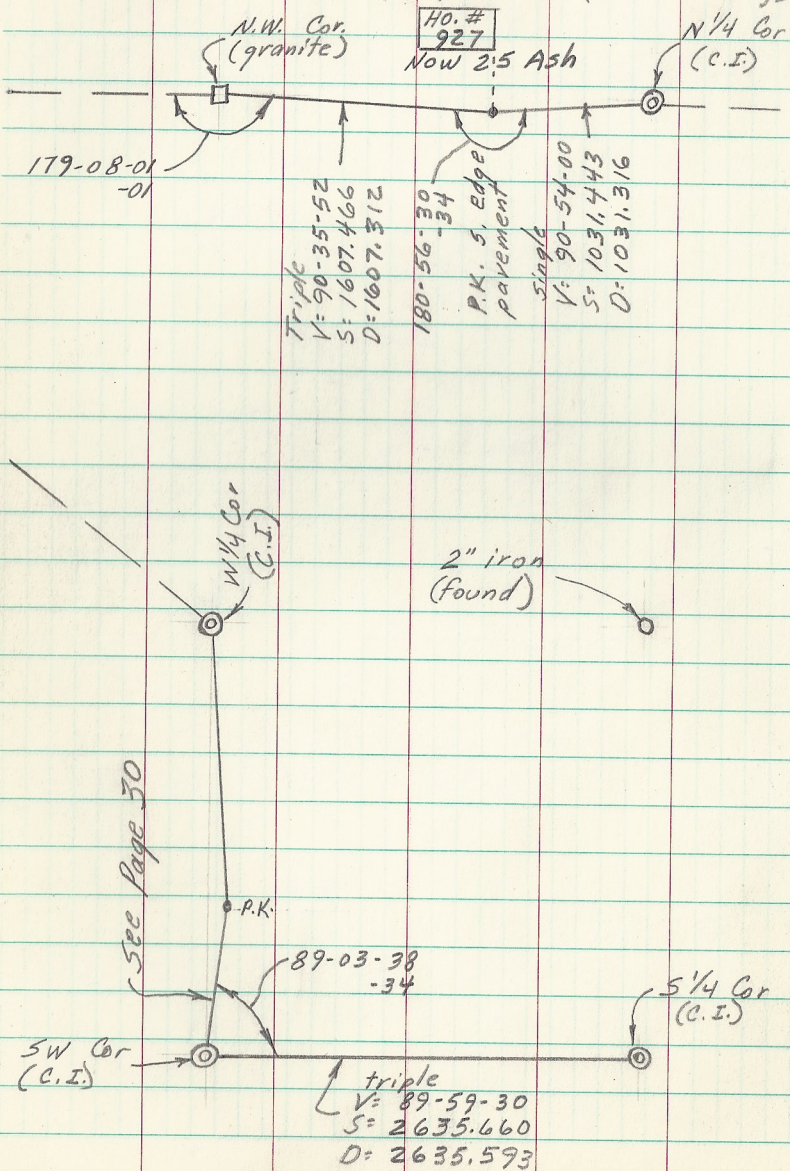

Jan - Feb., 1981

R.M.
P.K.
P.D.

32

