
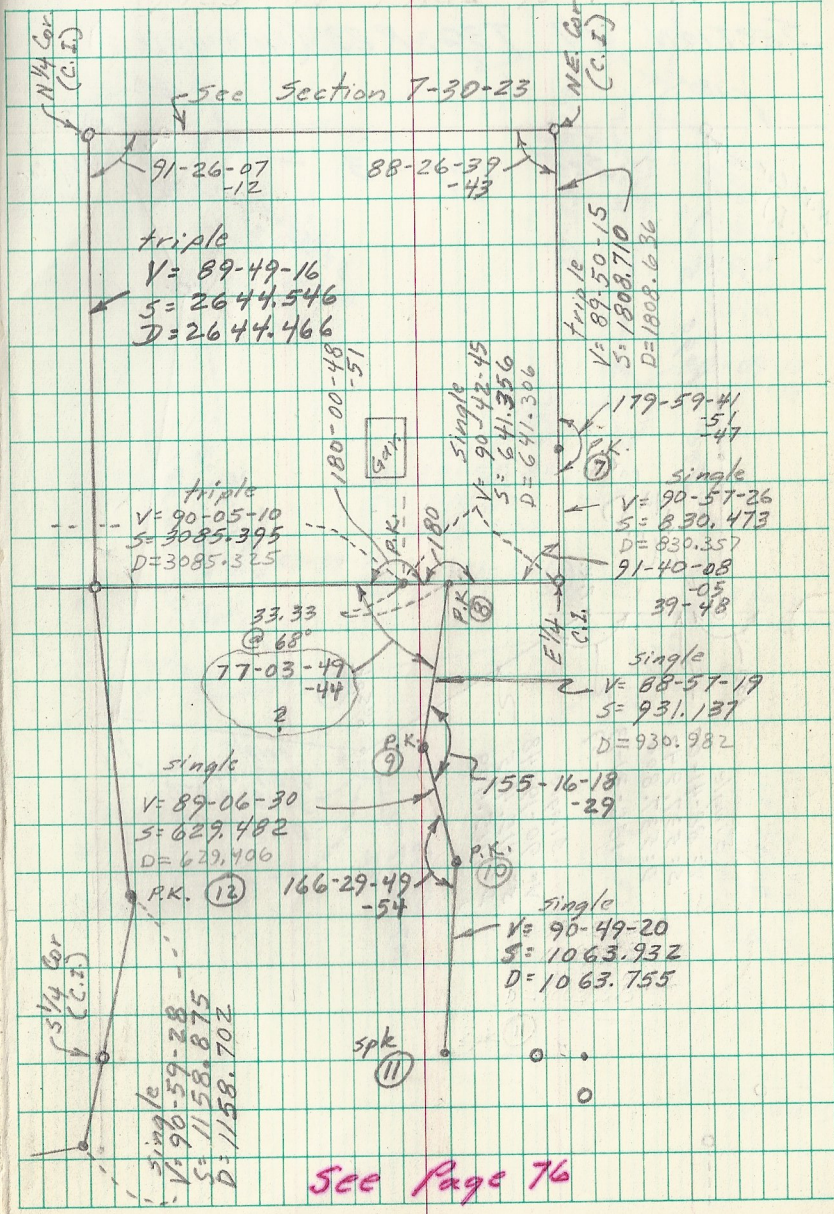


SECTION 18, T30, R23 (MEASURING)

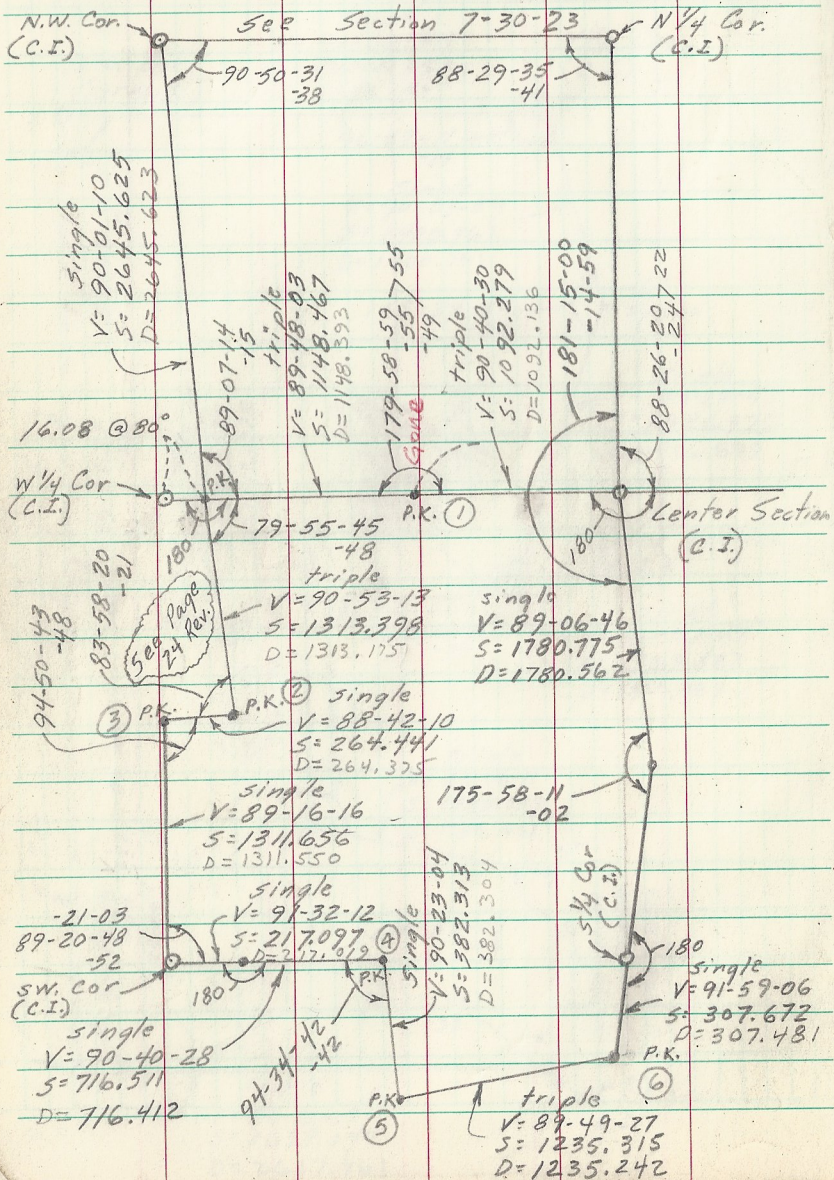

See Page 76