# SECTION 32, T30, R23

(MEASURING)

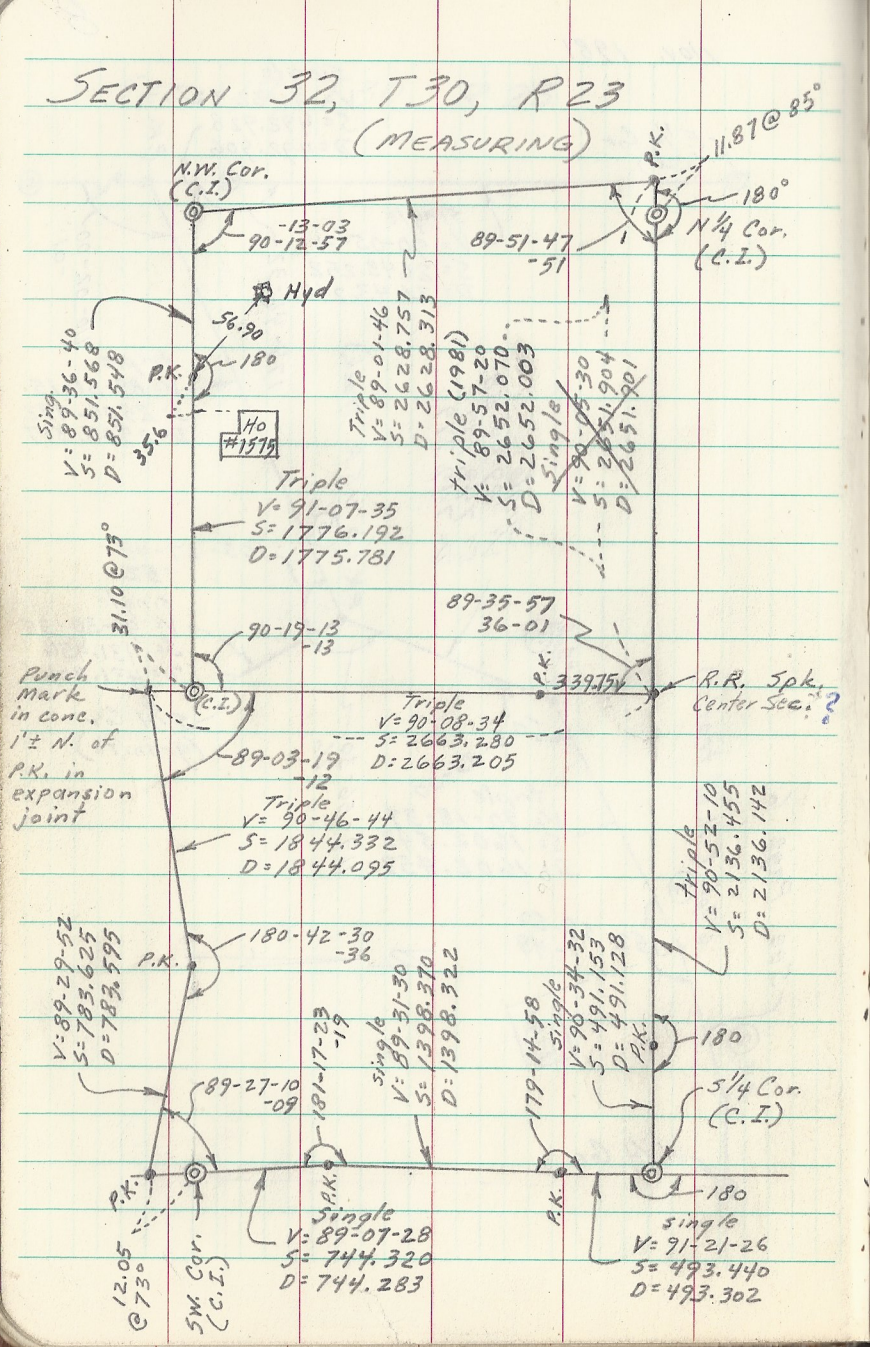

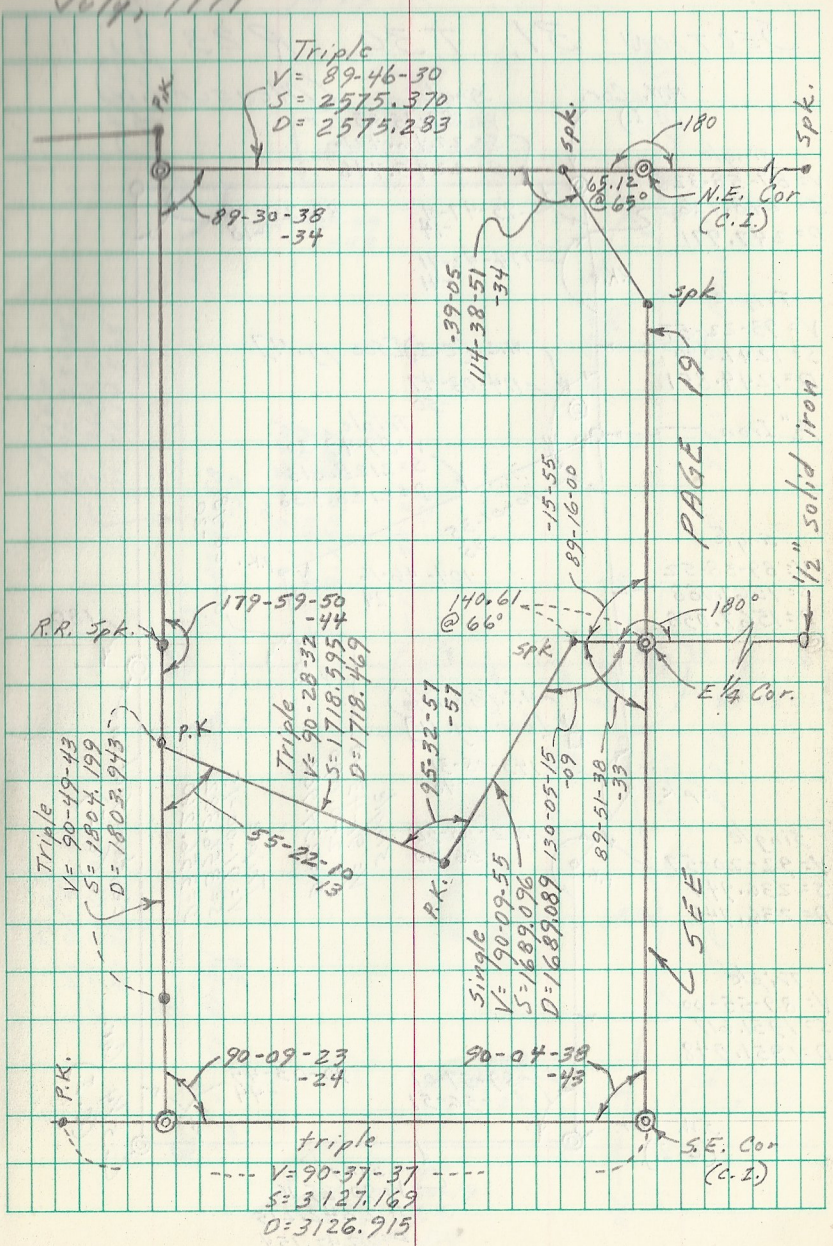
July, 1977