



SECTION 17, T29, R-23 (N 1/2)

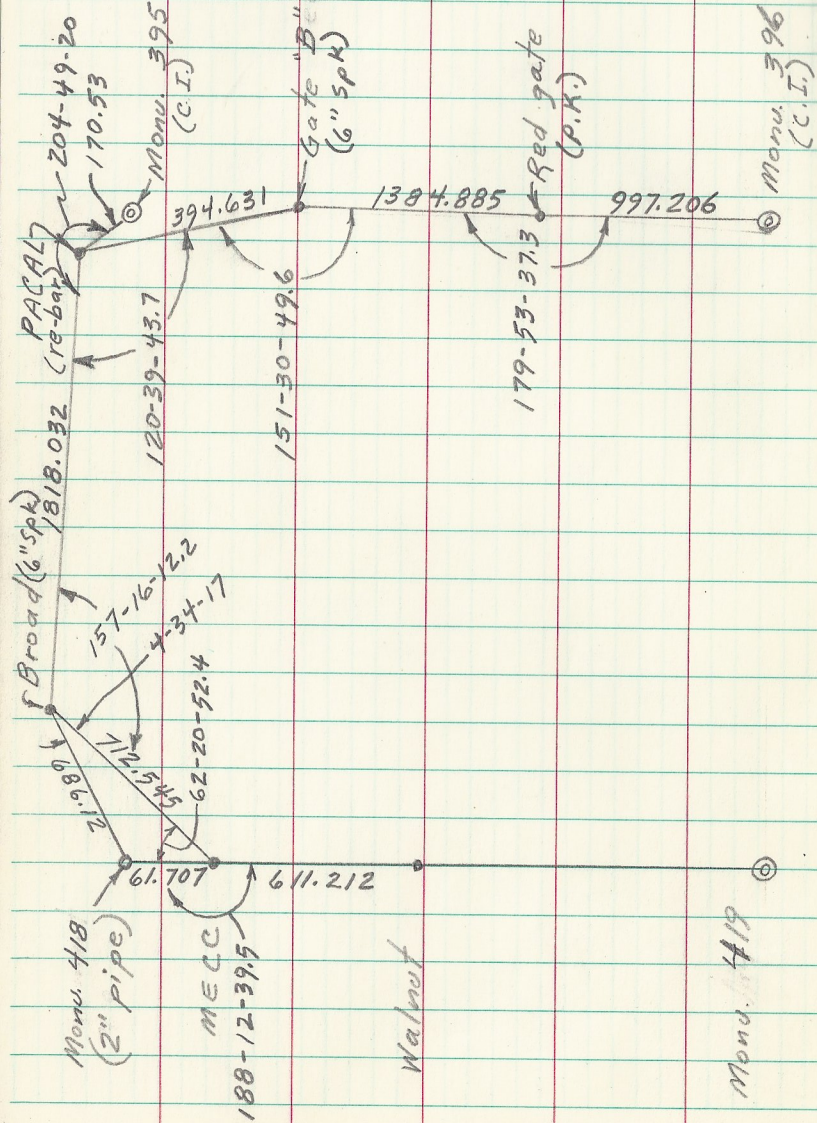

R.F.M.
L.P.D.
D.S.

1984

10

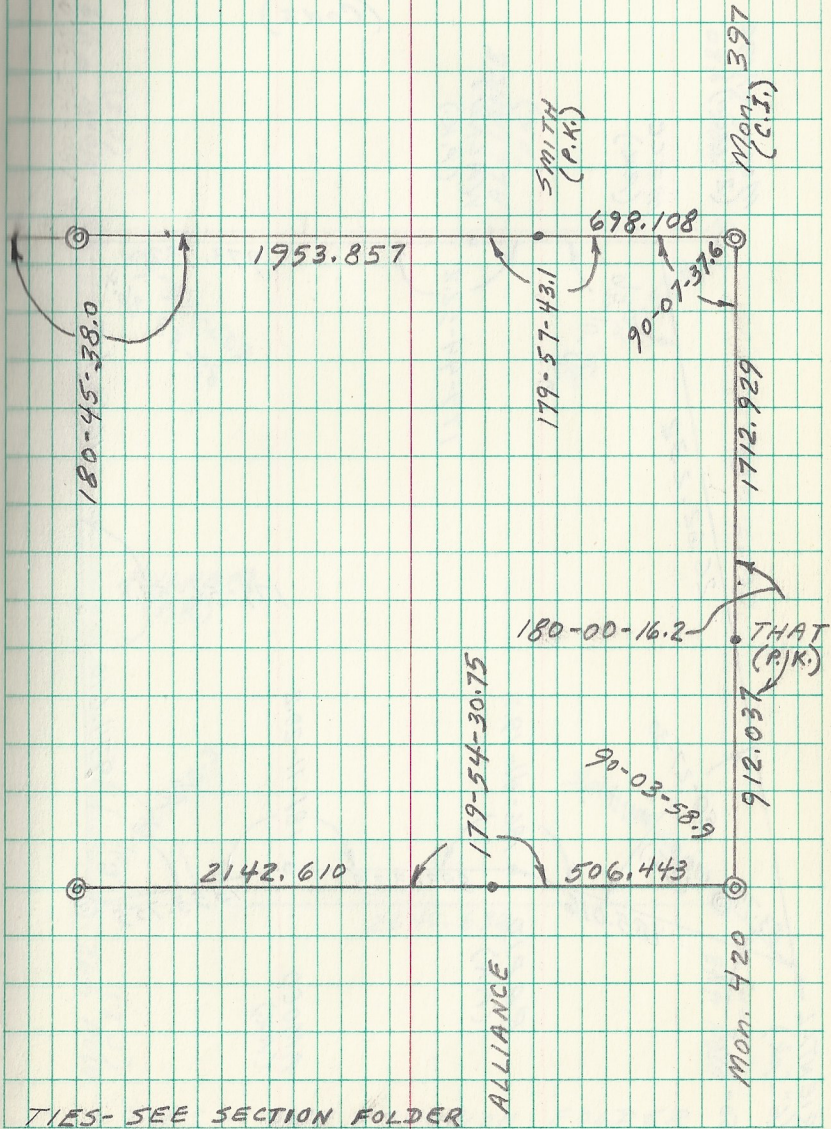

TIES-SEE SECTION FOLDER