W½ 1982 ±

SECTION 4, T29, R23 (Measuring)

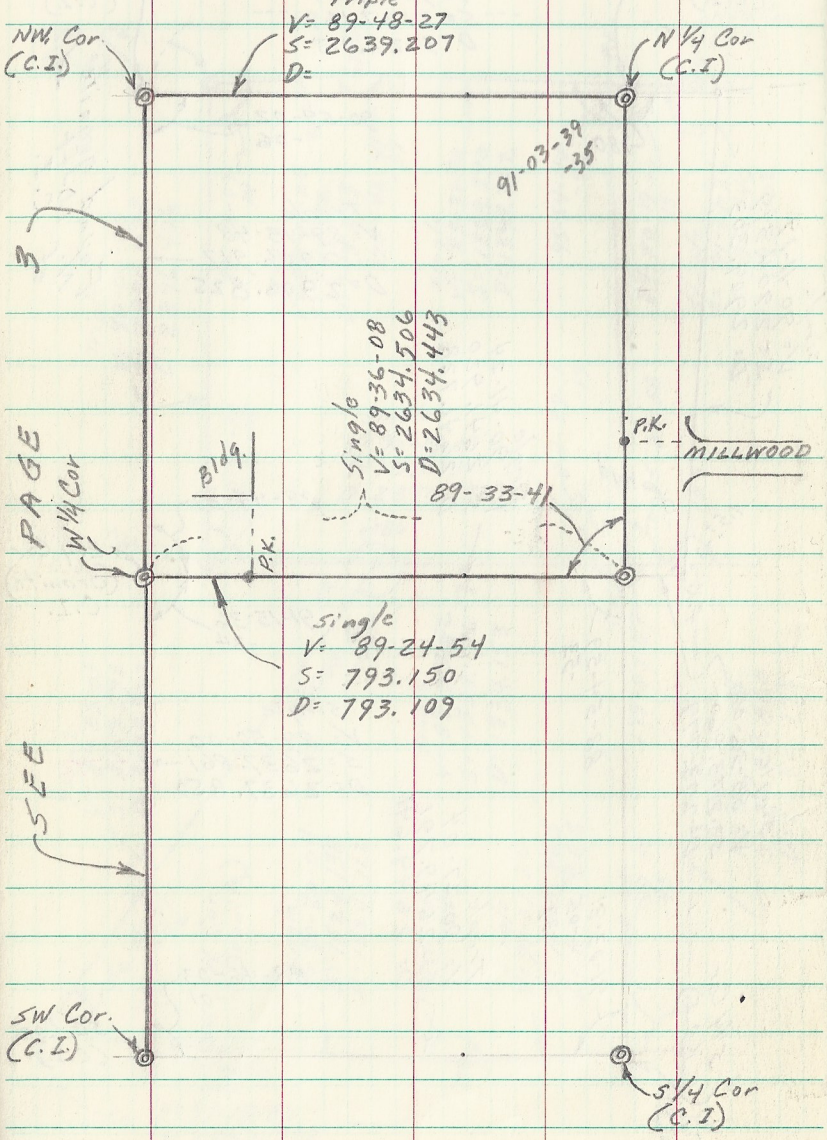

R.M.
L.P.D.
D.S.

E½ 3-85
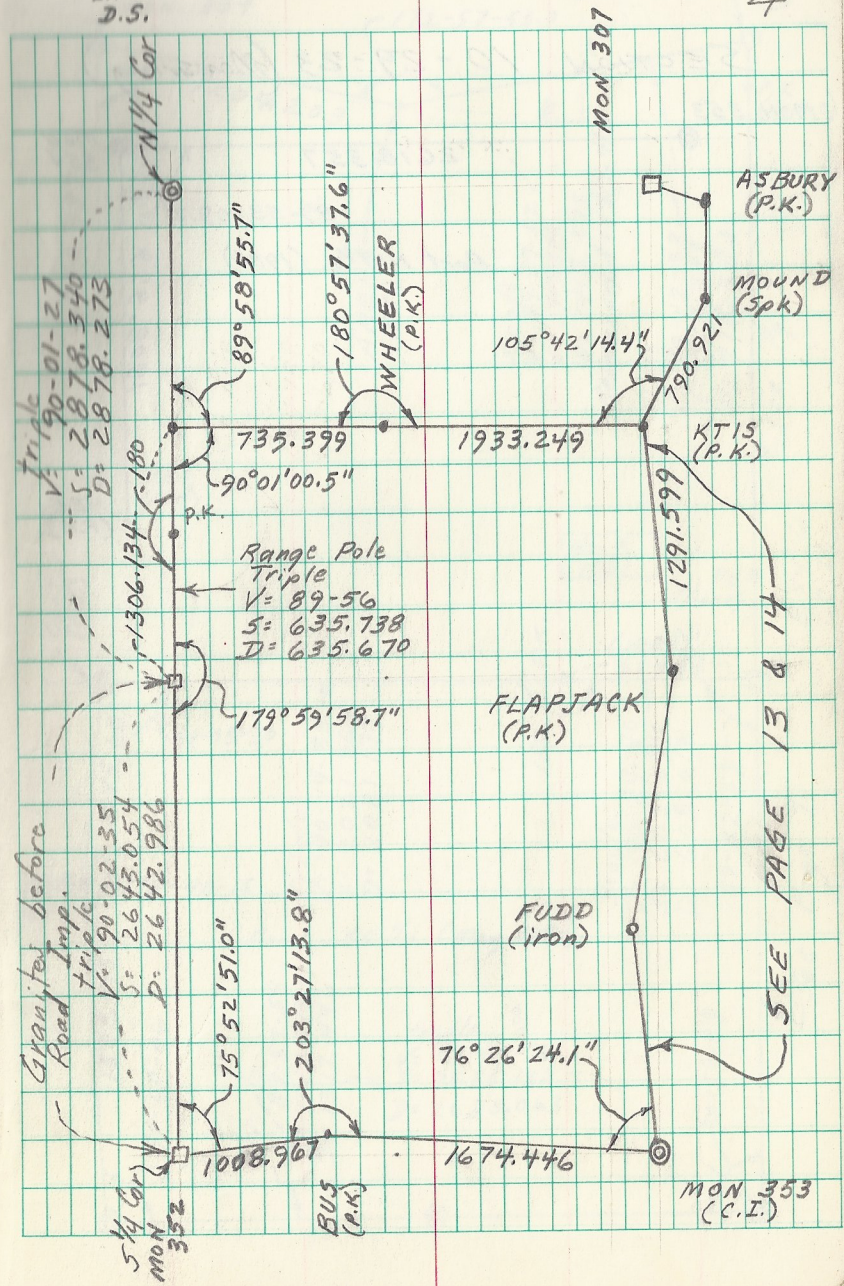
4