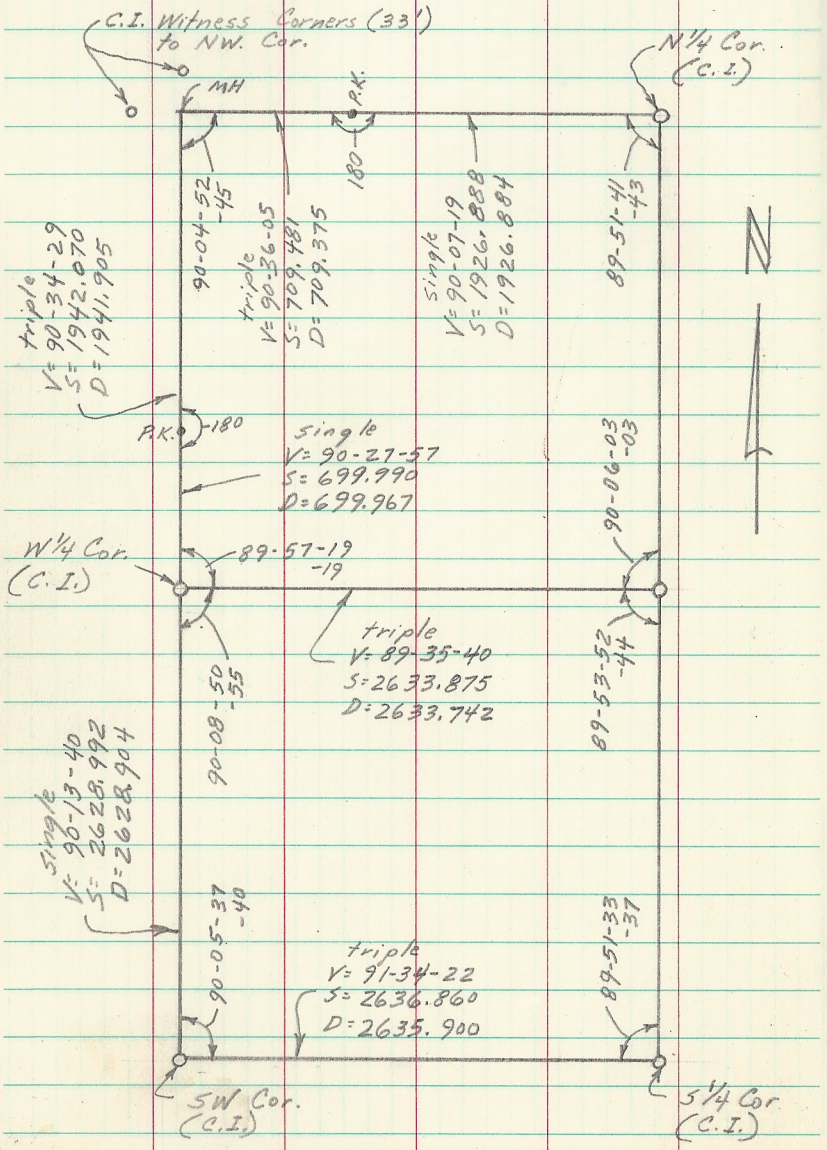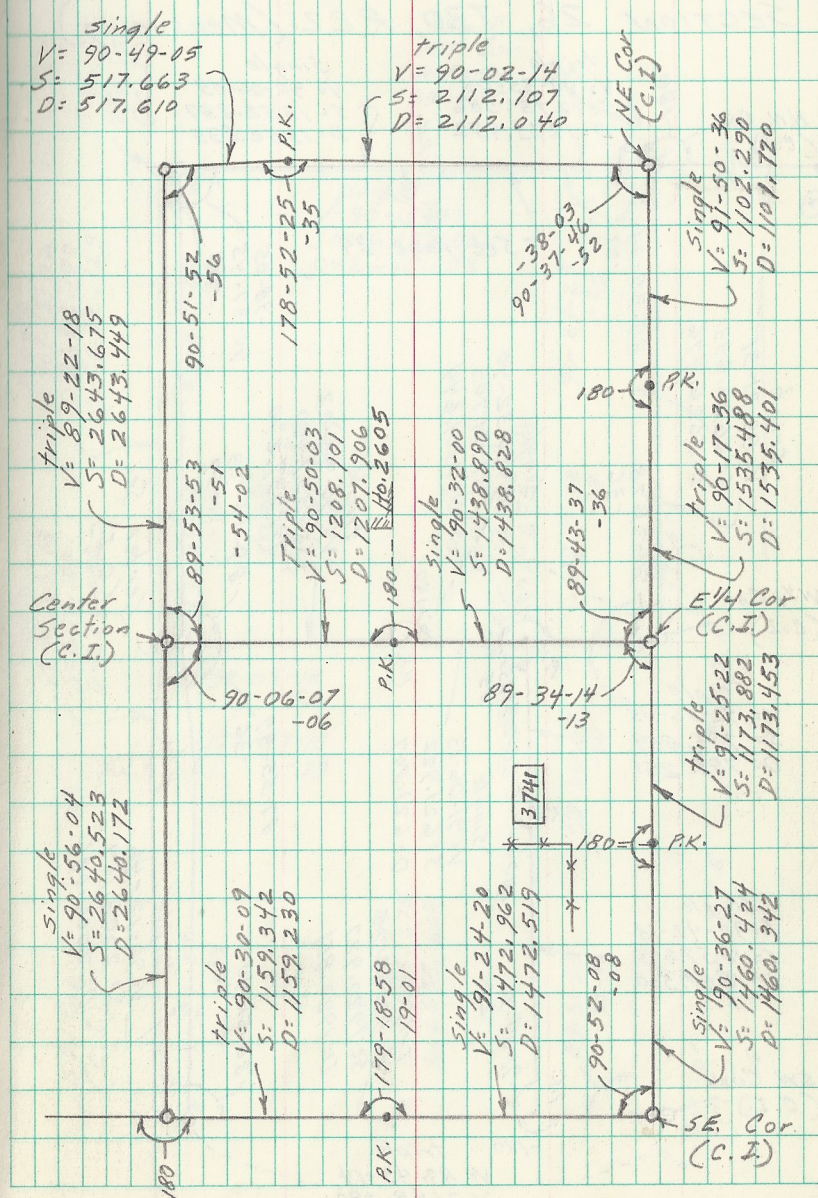SECTION 25, T 30, R22 (Measuring)