


SECTION 21, T30, R22 (Measuring)

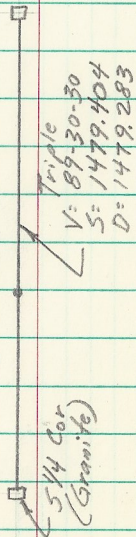

Ties on page 16

