


SECTION 23, T30, R22

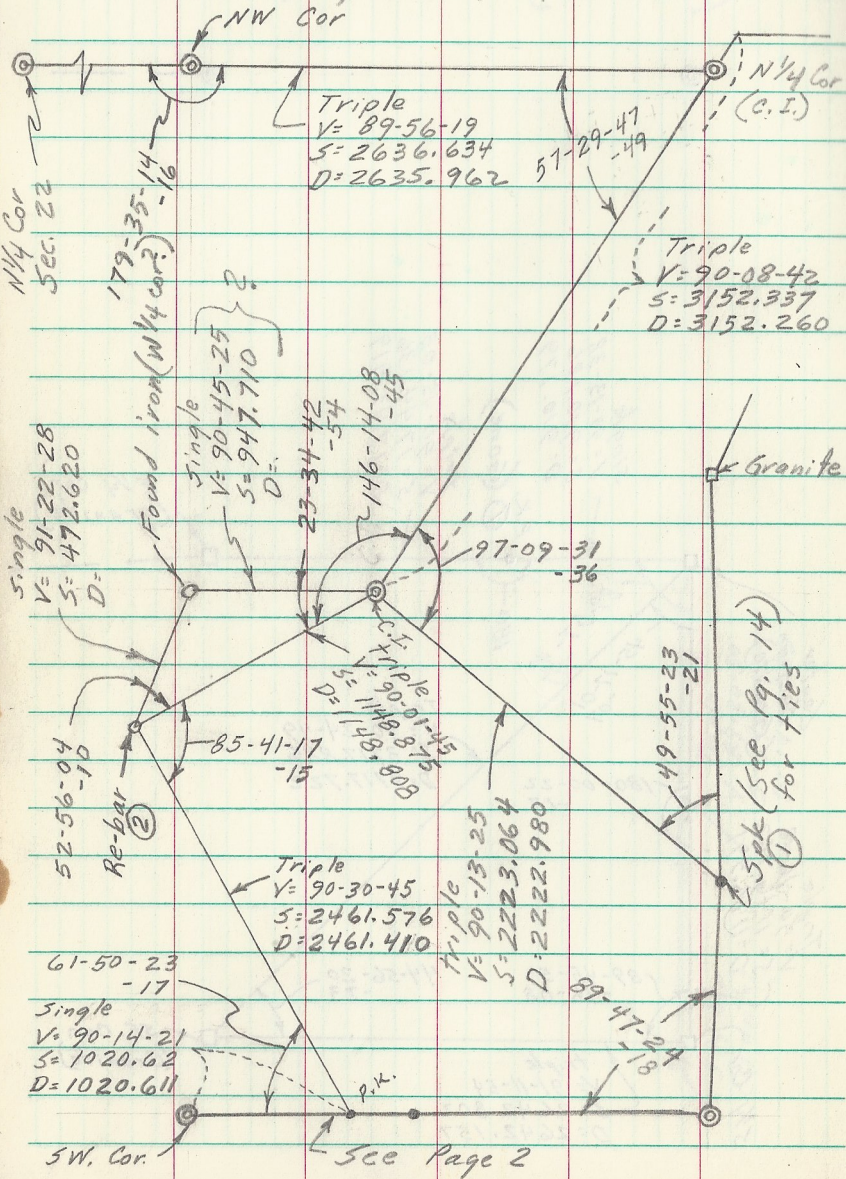

Single
 $V: 90-01-38$
 $S: 622.555$
 $D: 622.555$

13
 Feb. 1978
 March 1980

