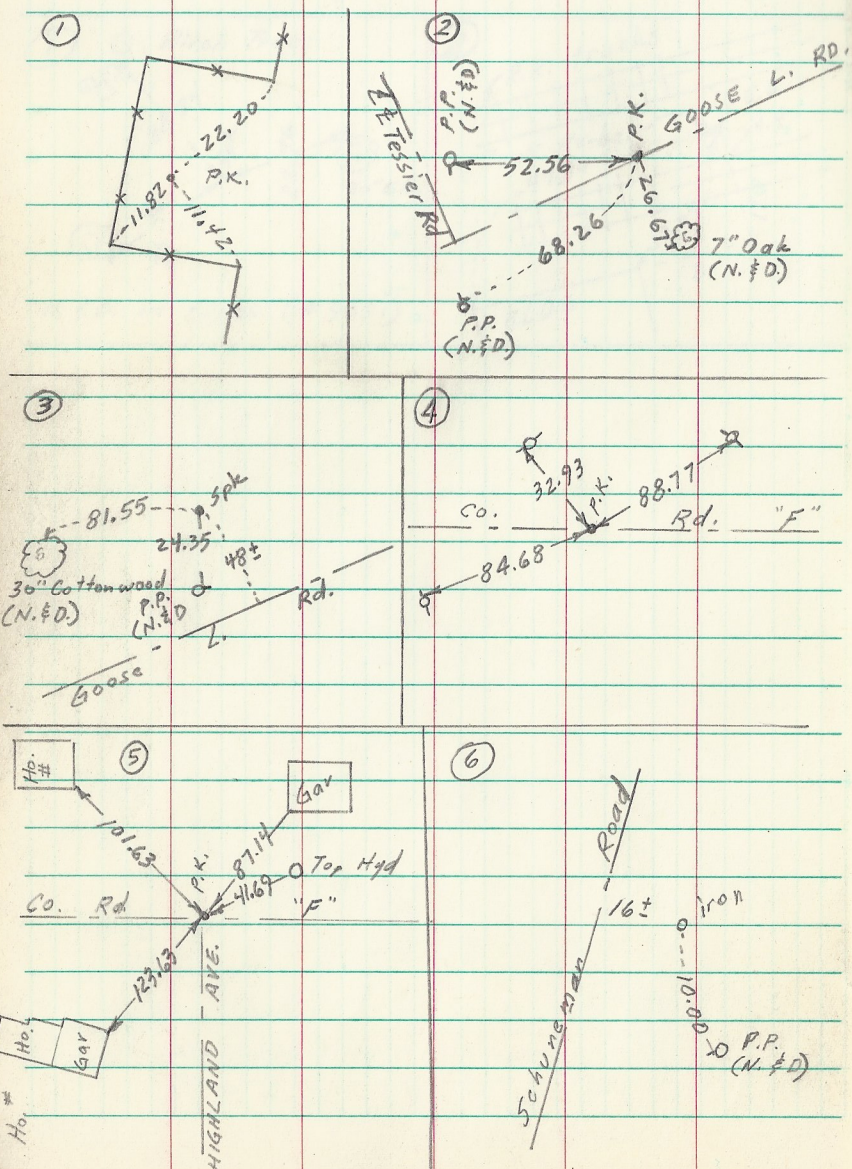Ties to Points in Section 26, 27 & 28, T30, R22.