



TRAVERSE

TIES N 1/2 SEC. 12-30-22

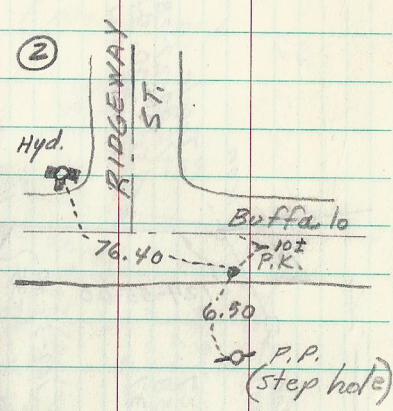

iron under telegraph lines

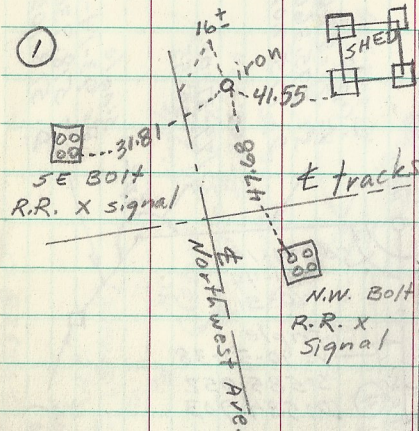