


# SECTION 1, T30, R22 (Measuring)

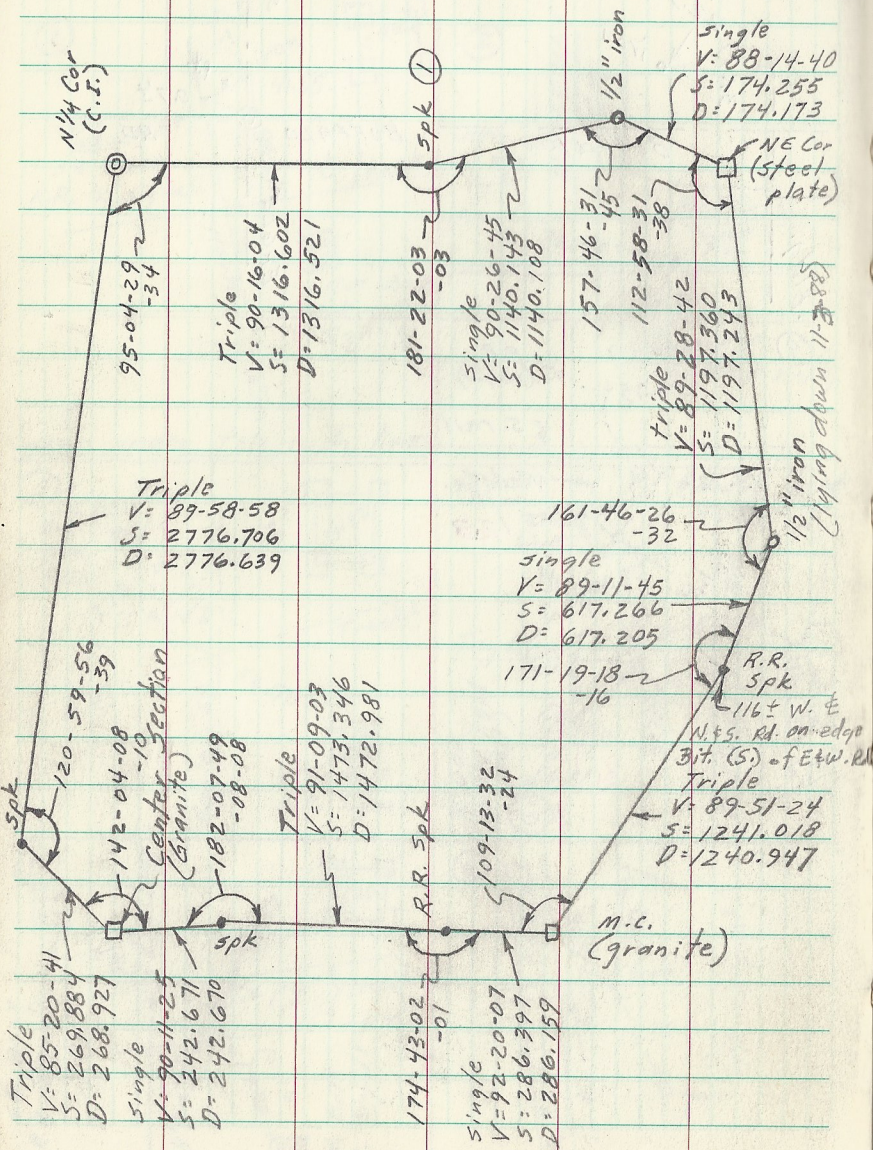

Dec. 1977

19

