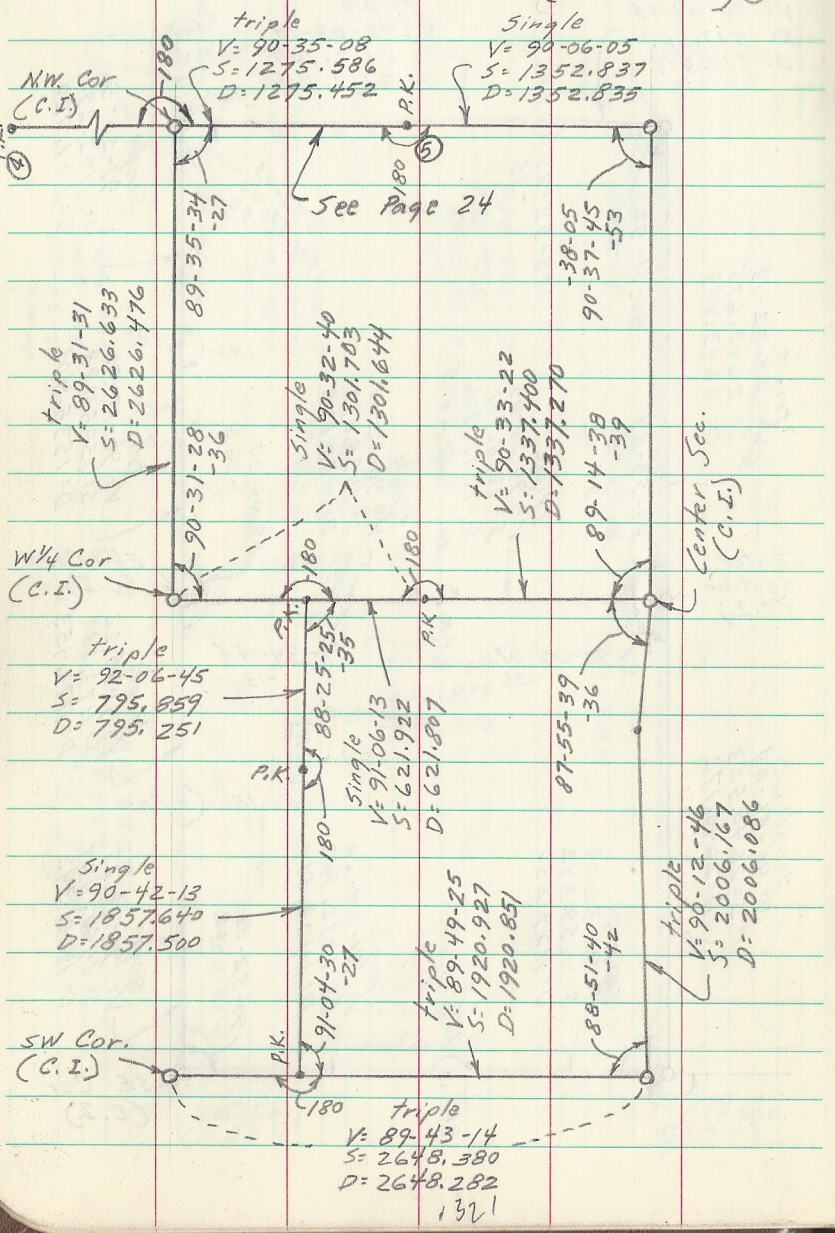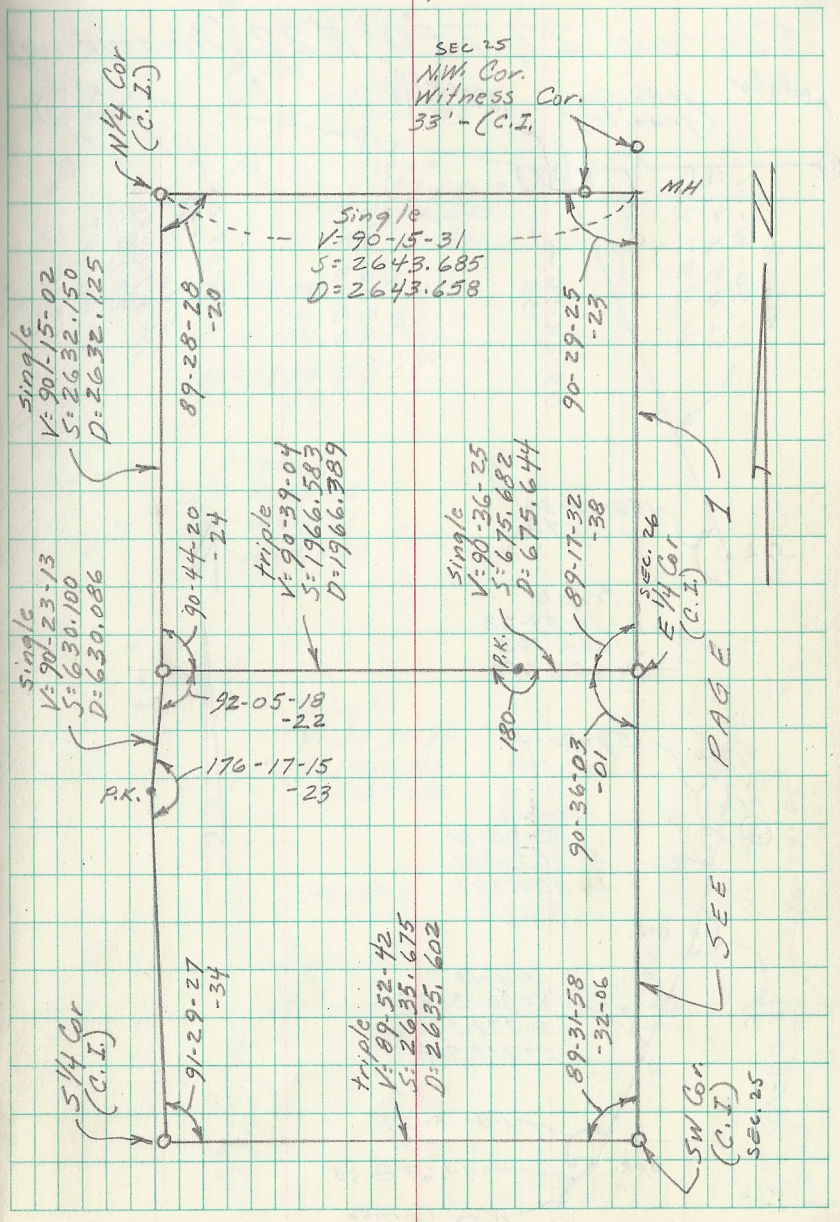SECTION 26, T30, R22 (Measuring)