


N $\frac{1}{2}$  SECTION 12, T30, R22  
 (Traverse to replace N $\frac{1}{4}$  Corner)

See page 17 for orig. traverse.

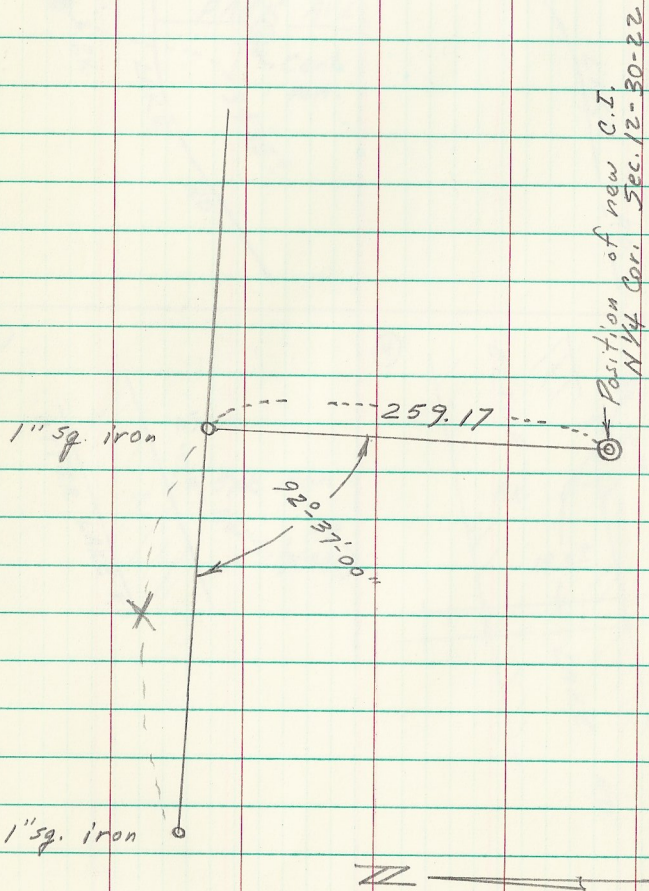

July 14, 1981

M.F.  
 L.P.D.  
 K.R.

23

