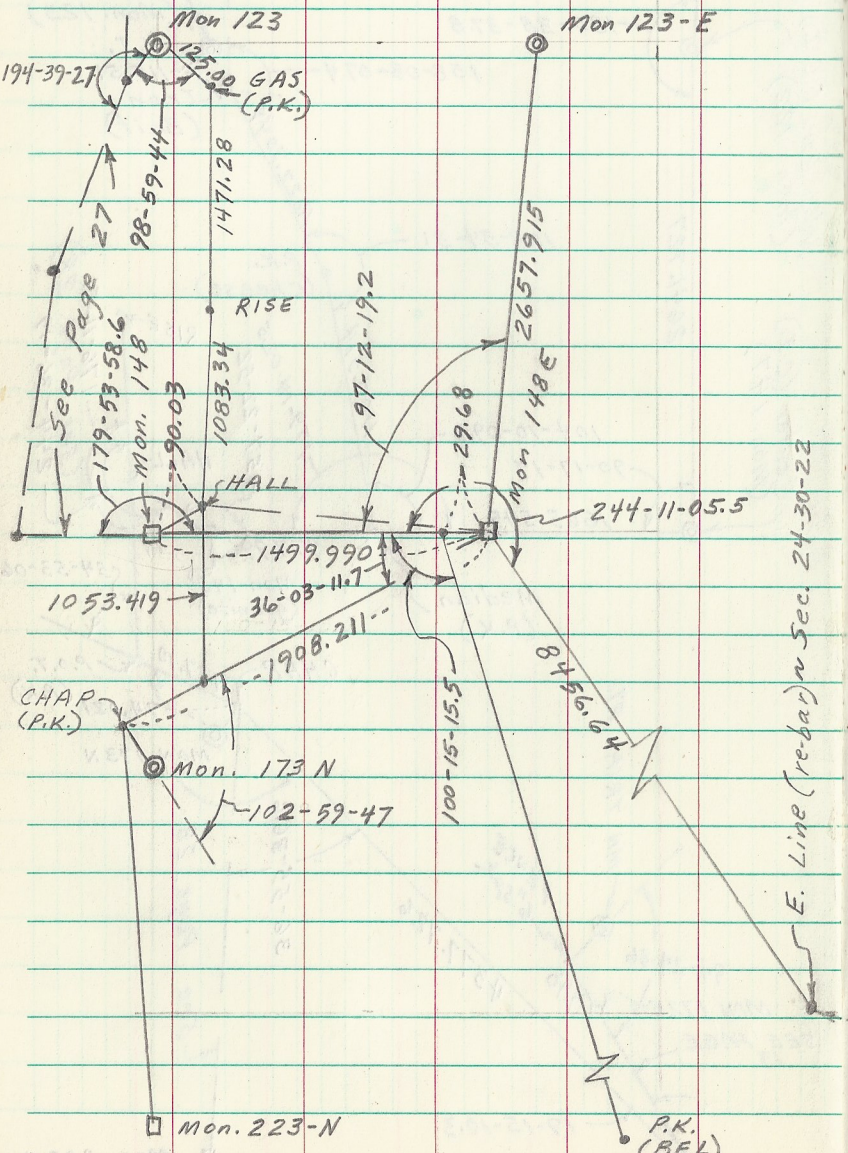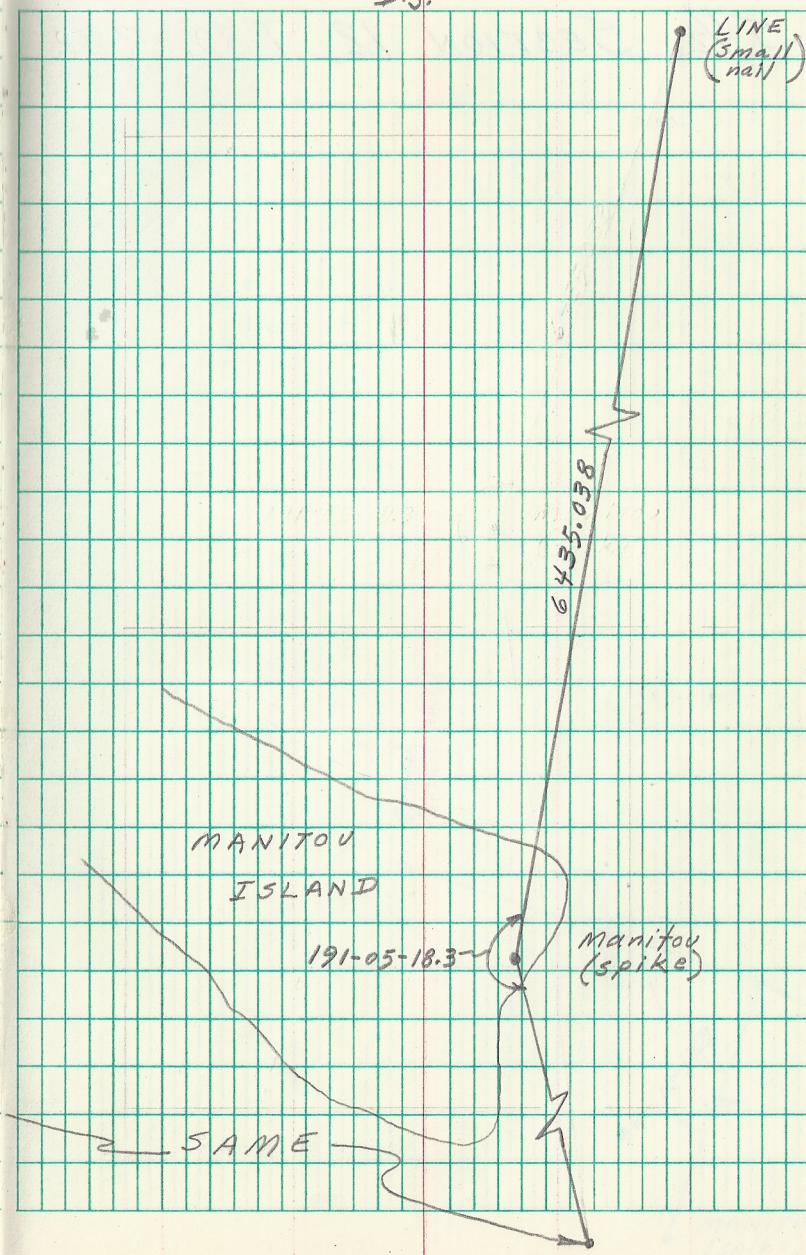SECTION 13, T30, R22.