


SECTION 27, T30, R22 (Measuring)

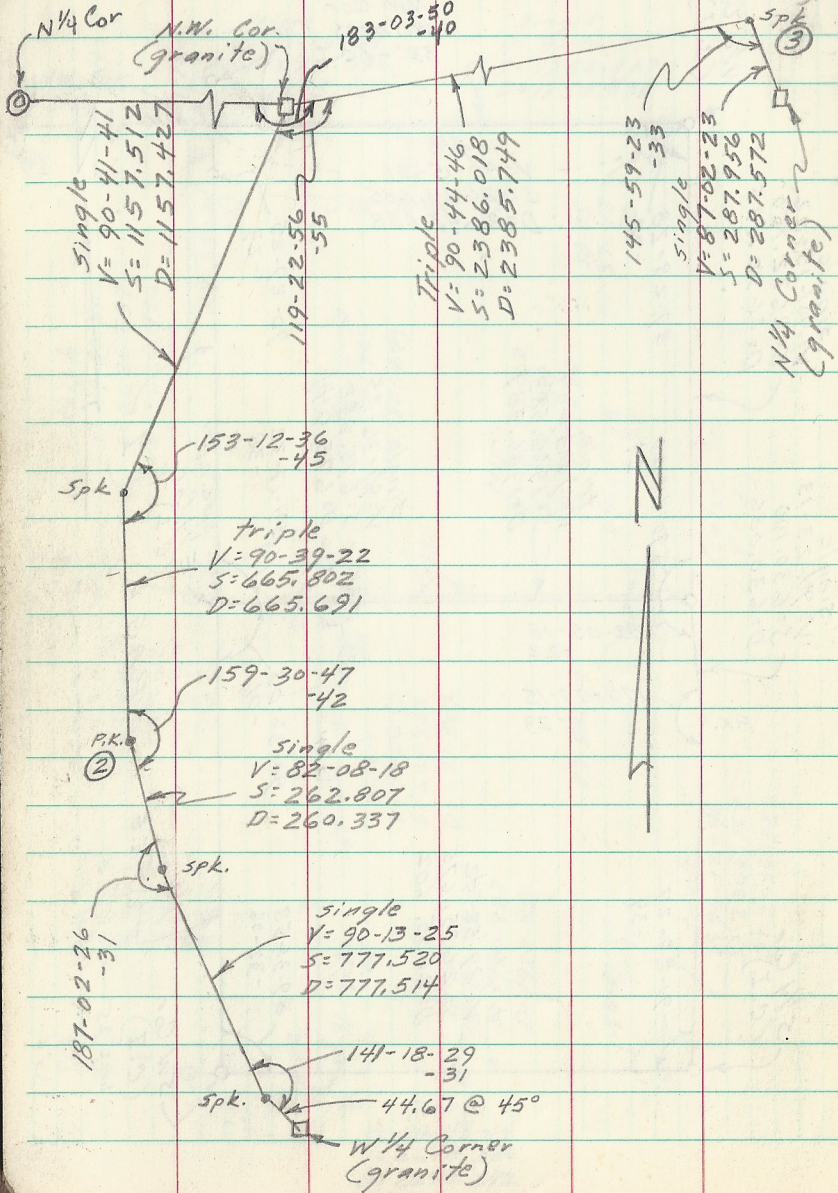

Spk Ties on Page 15

